

AG Contract No.: KR 00-1511TRN
ADOT ECS File No. JPA 00-114
Project: RAM 600-1-000 & RAM 600-1-563
TRACS: H 4830 03C & H 4845 03C
Section: SR 101L, Pima Freeway
19th Ave.-Scottsdale Rd.

INTERGOVERNMENTAL AGREEMENT
LANDSCAPE MAINTENANCE
BETWEEN
THE STATE OF ARIZONA
AND
THE CITY OF PHOENIX

96284 100

THIS AGREEMENT is entered into 21 March, 2001 pursuant to Arizona Revised Statutes Sections 11-951 through 11-954, as amended between the STATE OF ARIZONA, acting by and through its DEPARTMENT OF TRANSPORTATION (the "State") and the CITY OF PHOENIX, acting by and through its CITY MANAGER, (the "City").

I. RECITALS

1. The State is empowered by Arizona Revised Statutes Section 28-401 to enter into this agreement and has by resolution, a copy of which is attached hereto and made part hereof, resolved to enter into this agreement and has delegated to the undersigned the authority to execute this agreement on behalf of the State.
2. The City is empowered by Chapter II, Section 2.(i) of the City Charter to enter into this agreement and has by resolution, a copy of which is attached hereto and made a part hereof, resolved to enter into this agreement and has authorized the undersigned to execute this agreement on behalf of the City.
3. It is to the mutual advantage of the State and the City to landscape certain areas within the right of way on SR-101L at the following location.

From SR 101L centerline roadway station 1311+75 at 19th Ave. east to centerline roadway station 1853+62 at Scottsdale Rd. a total net distance of approximately 10.26 miles, as designated in the attached Maintenance Exhibit.

THEREFORE, in consideration of the mutual agreements expressed herein, it is agreed as follows:

NO. 24515
Filed with the Secretary of State
Date Filed: 03/21/01
Ketrey Bayless
Secretary of State
By Vicky J. Gruenewold

II. SCOPE OF WORK

1. The State will prepare to State standards design plans for the landscaping and irrigation construction project and submit them to the City for concurrence.
2. After City concurrence of the plans, the project will be constructed by the State, at State's expense. The State will use color coded irrigation pipe to indicate the presence of reclaimed water, as required by law.
3. The City will provide potable or reclaimed water mains up to or within the State's right of way at the City's expense. Reclaimed water shall be Class A, or better, as defined by Arizona Administrative Code (18 A.A.C. 11, Article 3) proposed May 5, 2000.
4. The City shall furnish and install necessary water services from water mains to the designated locations within the right of way at the State's expense. The City will authorize and pay or waive any water development fees.
5. The City shall furnish all potable or reclaimed water for the landscape project, and make its best efforts to provide the water at the design pressures stated in the plans, during installation, construction phase, and all water thereafter necessary to properly maintain the landscape, at City's expense.
6. All planned work by the City within the State's Control of Access shall be requested through the State's Phoenix Maintenance District Permits Office.
7. Should the City elect to deliver treated reclaimed water instead of potable water, the City shall furnish and maintain any additional equipment and electrical power required by the State to maintain design water pressures, and any equipment deemed necessary by the State to effectively interface with the State's existing irrigation system, all at the City's expense.
8. After construction, the State will maintain the landscaping, landform graphics and irrigation system, and pay for irrigation system electric, all generally within the Control of Access, as designated in the attached Maintenance Exhibit.
9. At the conclusion of the contractor maintenance and warranty period, referred to in the contract as Landscaping Establishment, the City shall maintain the irrigation system generally outside the Control of Access as designated on the Maintenance Exhibit, including all testing, adjusting, repairing and operation of the irrigation system. At this time, the City shall also assume responsibility of paying for electrical power necessary to operate the City's irrigation controllers and any booster pumps.
10. The City hereby agrees to maintain the landscaping in areas designated on the Maintenance Exhibit. Landscape maintenance shall consist of the care of all landscaping in accordance with accepted horticultural practices, keeping all areas free of weeds, undesirable grasses and litter, applying irrigation water, furnishing and applying insecticide/herbicide sprays and dust to combat diseases and other pests, pruning and replanting as required to maintain the landscaping.
11. All maintenance work shall be conducted in a manner to minimize traffic congestion and interference with through traffic. All traffic control shall meet the requirements of the Arizona Department of Transportation's "Uniform Traffic Control Manual."

III. MISCELLANEOUS PROVISIONS

1. This agreement shall become effective upon filing with the Secretary of State.
2. The terms, conditions and provisions of this agreement shall remain in full force and effect for a period of five (5) years from the effective date, unless this agreement violates any Arizona law, rule or regulation, either now enacted or which may be enacted in the future. This agreement will be automatically renewed for successive periods of five (5) years unless either party shall give notice in writing to the other not less than one (1) month nor more than three (3) months prior to the initial or renewed expiration date. Further, this agreement may be terminated by either party at any time upon sixty (60) days written notice. It is understood and agreed that, in the event this agreement is terminated by the City, the State shall in no way be obligated to maintain said landscaping.
3. This agreement may be cancelled in accordance with Arizona Revised Statutes Section 38-511.
4. The provisions of Arizona Revised Statutes Section 35-214 are applicable to this contract.
5. In the event of any controversy which may arise out of this agreement, the parties hereby agree to abide by required arbitration as is set forth for public works contracts in Arizona Revised Statutes Section 12-1518.
6. All notices or demands upon any party to this agreement shall be in writing and shall be delivered in person or sent by mail addressed as follows:

Arizona Department of Transportation
Joint Project Administration
205 South 17th Avenue, Mail Drop 616E
Phoenix, AZ 85007

City of Phoenix
Street Transportation Department
200 West Washington, 5th Floor
Phoenix, AZ 85003-1611

7. Attached hereto is the written determination of each party's legal counsel the parties are authorized under the laws of this state to enter into this agreement and that the agreement is in proper form.

IN WITNESS WHEREOF, the parties have executed this agreement the day and year first above written.

CITY OF PHOENIX, a Municipal
Corporation , Frank Fairbanks
City Manager

By Thomas E. Callow
THOMAS E. CALLOW, P.E.
Street Transportation Director

STATE OF ARIZONA
Department of Transportation

By Catherine J. Hegel
CATHERINE J. HEDEL
Contract Administrator

ATTEST

By Vicky Miel
VICKY MIEL
City Clerk

APPROVAL OF THE CITY OF PHOENIX ATTORNEY

I have reviewed the above referenced proposed intergovernmental agreement, between the DEPARTMENT OF TRANSPORTATION, INTERMODAL TRANSPORTATION DIVISION, and the CITY OF PHOENIX and declare this agreement to be in proper form and within the powers and authority granted to the City under the laws of the State of Arizona. No opinion is expressed as to the authority of the State to enter into this agreement.

DATED this _____ day of _____, 2001.


William J. Bock

ACTING
DJB City Attorney

RESOLUTION

BE IT RESOLVED on this 25th day of July 2000, that I, the undersigned MARY E. PETERS, as Director of the Arizona Department of Transportation, have determined that it is in the best interests of the State of Arizona that the DEPARTMENT OF TRANSPORTATION, acting by and through the Intermodal Transportation Division, to enter into an agreement with the CITY OF PHOENIX for the purpose of defining responsibilities for landscaping certain areas within the right of way on SR 101I, from 19th Avenue east to Scottsdale Road.

Therefore, authorization is hereby granted to draft said agreement which, upon completion, shall be submitted to the Contractor Administrator for approval and execution.

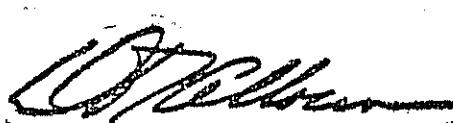

DAVID R. ALLOCCO, P.E.
Assistant State Engineer
Engineering Technical Group

for MARY E. PETERS, Director

| STATION | POINT | PROJECT NO. | TYPE | TOTAL LEN. | WIDE | SL. |
|---------|-------|----------------|------|---------------|------|-----|
| 9 | MID | TRAV 600-1-562 | | | | |
| | | DOL MA 024 | | | | |



CITY OF PHOENIX
PLAT

PP# 00-04


1 OF 47

MAP/C LINE-SITE 1322-00

FRONTAGE ROAD WESTBOUND

8TH RAMP OFF RAMP WESTBOUND

LOOP 10 - WESTBOUND

Beginning of Project TRAV 600-1-562
Sect. 337-5

8TH RAMP

8TH RAMP EASTBOUND

FRONTAGE ROAD - EASTBOUND

.0001



0 25 50 100 150










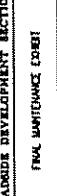




| TRANS. STATION | PROJECT NO. | WEIGHT TOTAL | # BARS |
|----------------|---------------|--------------|--------|
| NUMBER | | WEIGHT | |
| 9 | RAM 600-1-562 | | |
| | DIL MA 024 | | |



CITY OF PHOENIX

| | |
|---|---------|
| P# - 00-1H | |
| ARIZONA DEPARTMENT OF TRANSPORTATION HIGHWAY INSPECTION AND ROADBED INSPECTION DIVISION | |
| ROUTE 101 MILE 0.00 | |
| TRAIL MAINTENANCE, ERB#1 | |
| ROUTE | SECTION |
| SR 101 | 100 |
| 0 25 50 100 150 | |



TRACS NO 11 4RDN 03 C RAM 600-1-562 D NCF 47

MATCH LINE - STA 1334.00

1339.00


LOOP 10 - WESTBOUND
10 - EASTBOUND

1325.00

18TH AVE. ON RAMP - EASTBOUND
Chain Link Fence

FRONTAGE ROAD - EASTBOUND


MATCH LINE - STA 1322.00

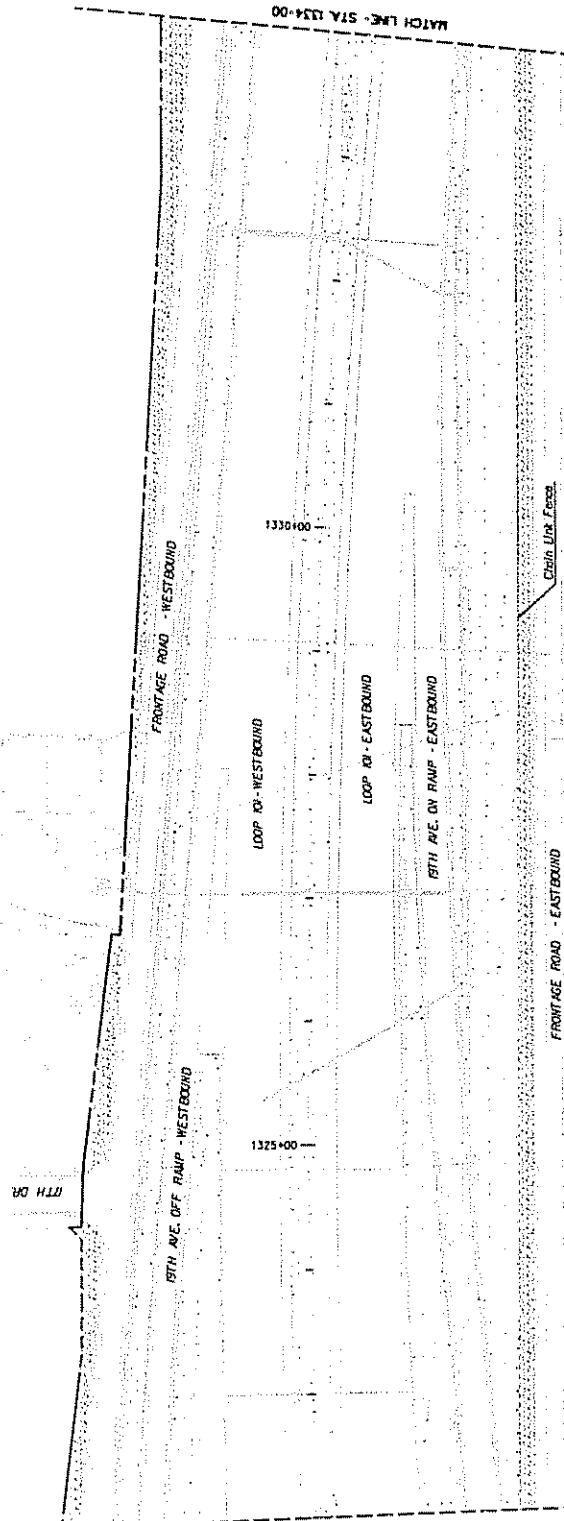

NOTE: MAINTENANCE RESPONSIBILITY EXTENDS NORTH TO RIGHT-OF-WAY AND FENCE.

| | | | | | |
|---------|-------|----------------|----------------|-------------|----------|
| STATION | STATE | PROJECT NO. | SPANNING DIST. | WEEKLY COST | ME. RATE |
| 9 | MA | RAIL 600-1-042 | | | |

RAIL MA 024

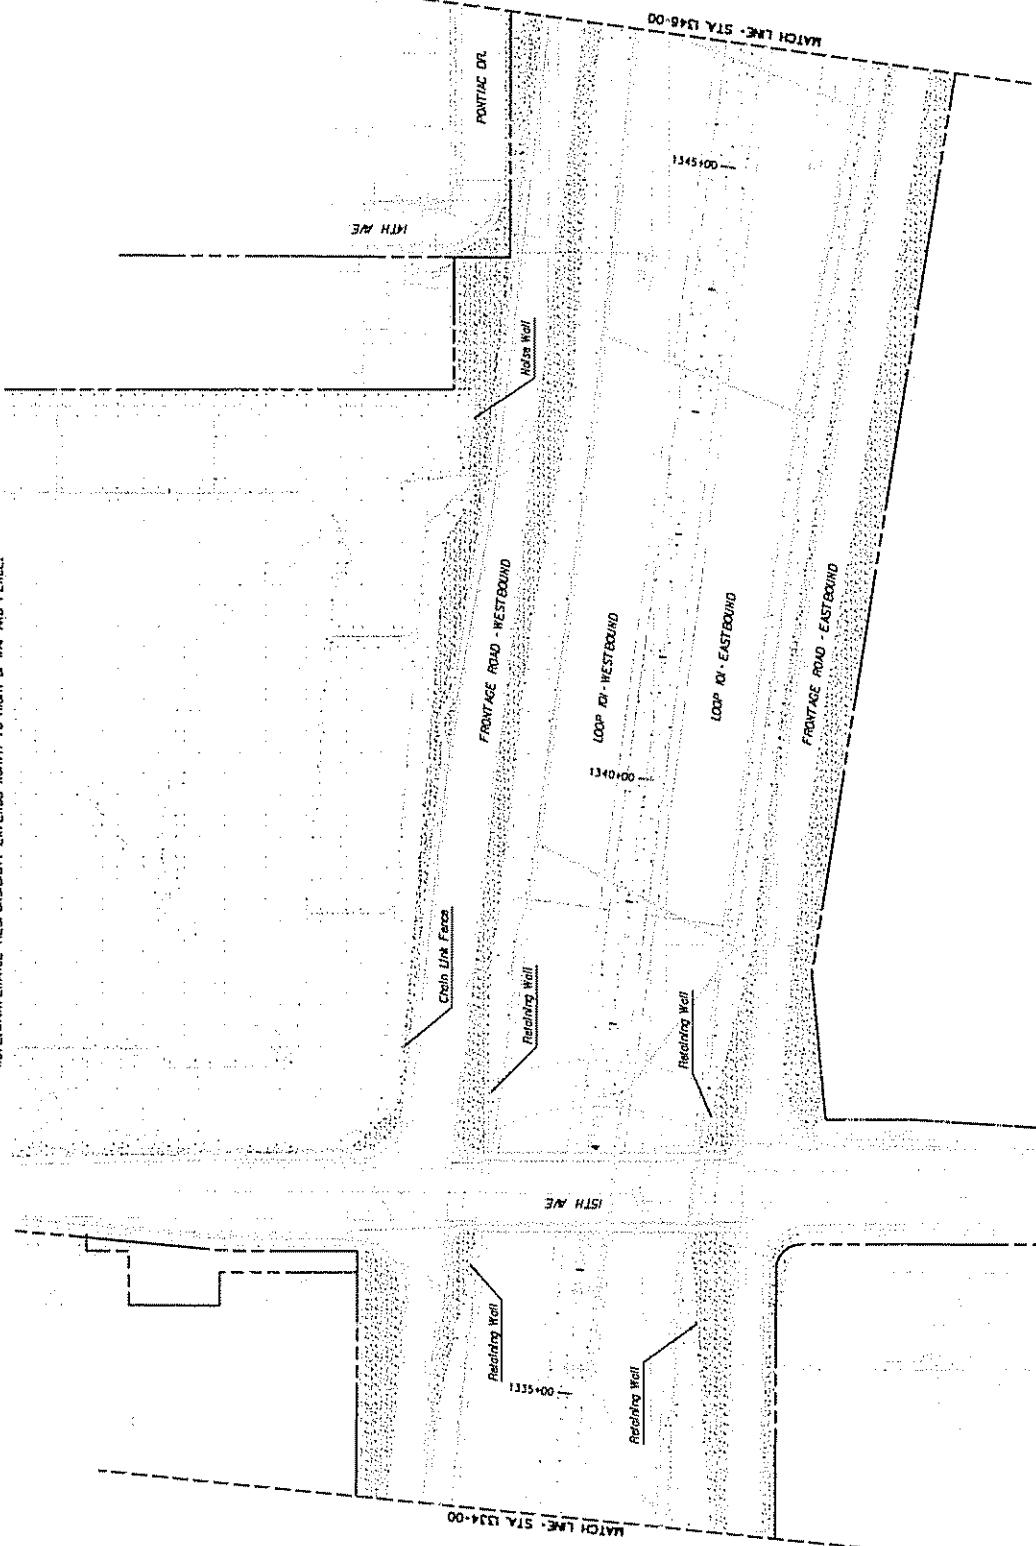

A001

CITY OF PLEASANT

SPK-00-1A





LOGAN DIVISION DESIGN INC.
233-100
0 25 50 100 150
SR 10L 19TH AVENUE TO SCOTTSDALE ROAD


| | | | | |
|------|-------|----------------|--------------|-------------|
| FAMA | STATE | PROJECT NO. | SPANN. TONN. | AS BUILT |
| 9 | ARIZ. | RIAM 500-1-582 | 100 | |
| | | | | DATE MA 024 |

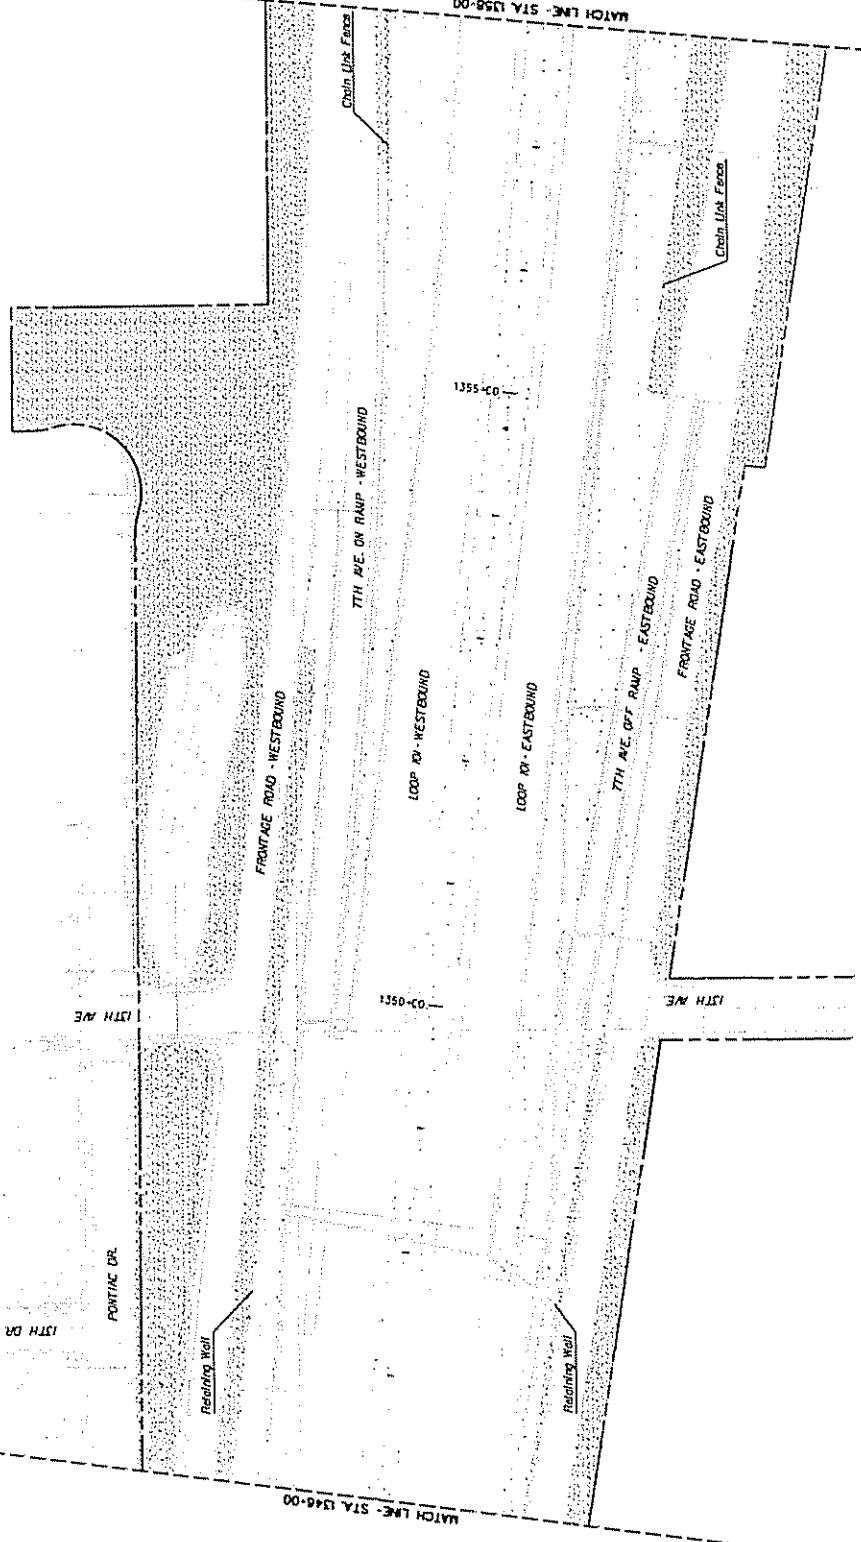

| | |
|--|-------------|
| CITY OF PHOENIX | |
| SPAN-00-114 | |
| ARIZONA DEPARTMENT OF TRANSPORTATION | |
| ARIZONA HIGHWAY DIVISION | |
| INTERSTATE HIGHWAY DEVELOPMENT SECTION | |
| DATE ISSUED 05/02/2002 | |
| LOGAN SIMMONS DESIGN INC | |
| FINAL MAINTENANCE DRAWING | |
| 288-1000 | |
| 13TH AVENUE TO SCOTTSDALE ROAD | 13TH AVENUE |

0 25 50 100 150




0 25 50 100 150




100 200 

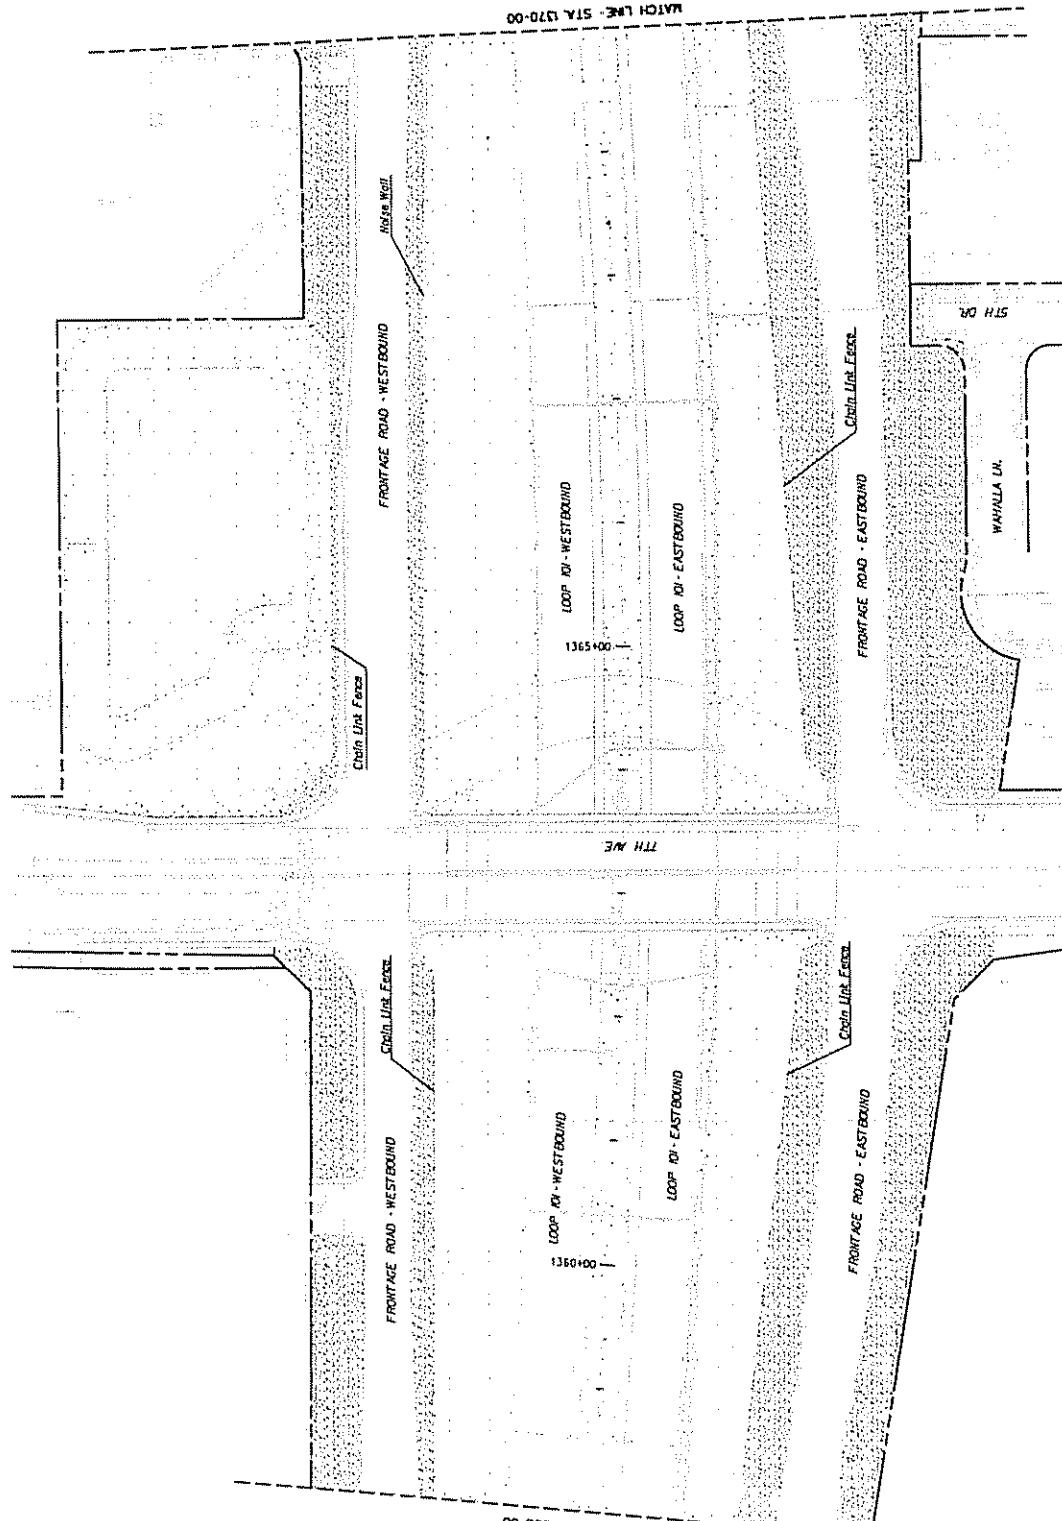

| | |
|---------------------------|--|
| PAK-00114 | |
| NAME | ARIZONA DEPARTMENT OF TRANSPORTATION INTERSTATE HIGHWAY ROADSIDE DEVELOPMENT SECTION |
| OWNER | LOGAN IMPERIAL DESIGN INC |
| FINAL MAINTENANCE DRAWING | |
| SR 101L | SECTION 19TH AVENUE TO SCOTTSDALE ROAD |
| 2188-000 | |
| 0 25 50 100 150 | |



CITY OF PHOENIX
STREET NAME INDEX

SPK 00-14



ARIZONA DEPARTMENT OF TRANSPORTATION
INTERSTATE TRANSPORTATION DIVISION
ROADSIDE DEVELOPMENT SECTION
ROUTE 101
TRUNK MAINTENANCE EXIST

SR 101L 19TH AVENUE TO SCOTTSDALE ROAD




0 25 50 100 150
FEET


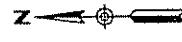


4001

MATCH LINE STA 1370-00
MATCH LINE STA 1362-00

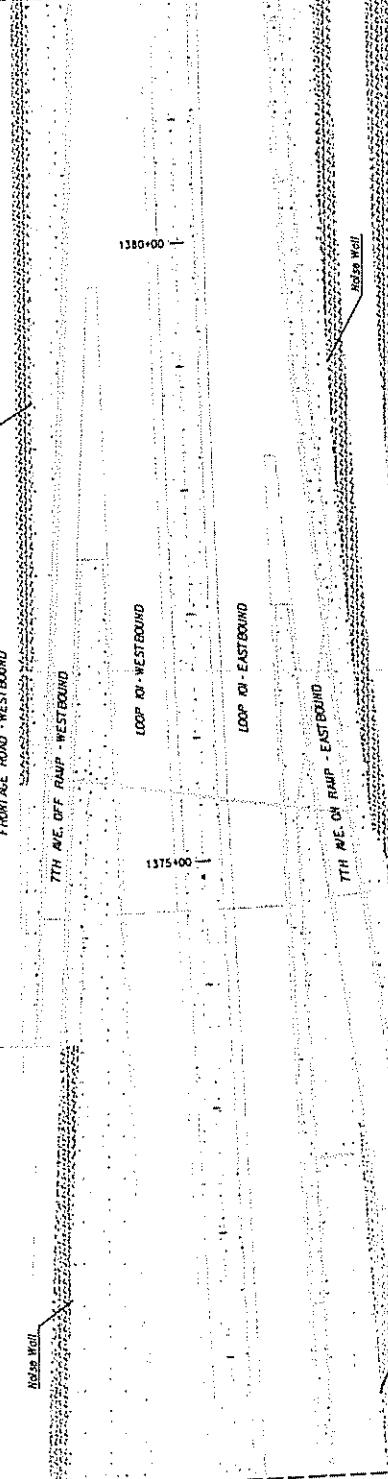

| TASK | STANT | PROJECT NO. | WEIGHT | TYPE | W. RATE |
|------|------------|---------------|--------|------|---------|
| NO. | DESC. | | ACT. | ACT. | |
| 9 | PLANT | RAM 600-1-562 | | | |
| | VOL MA OR4 | | | | |

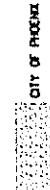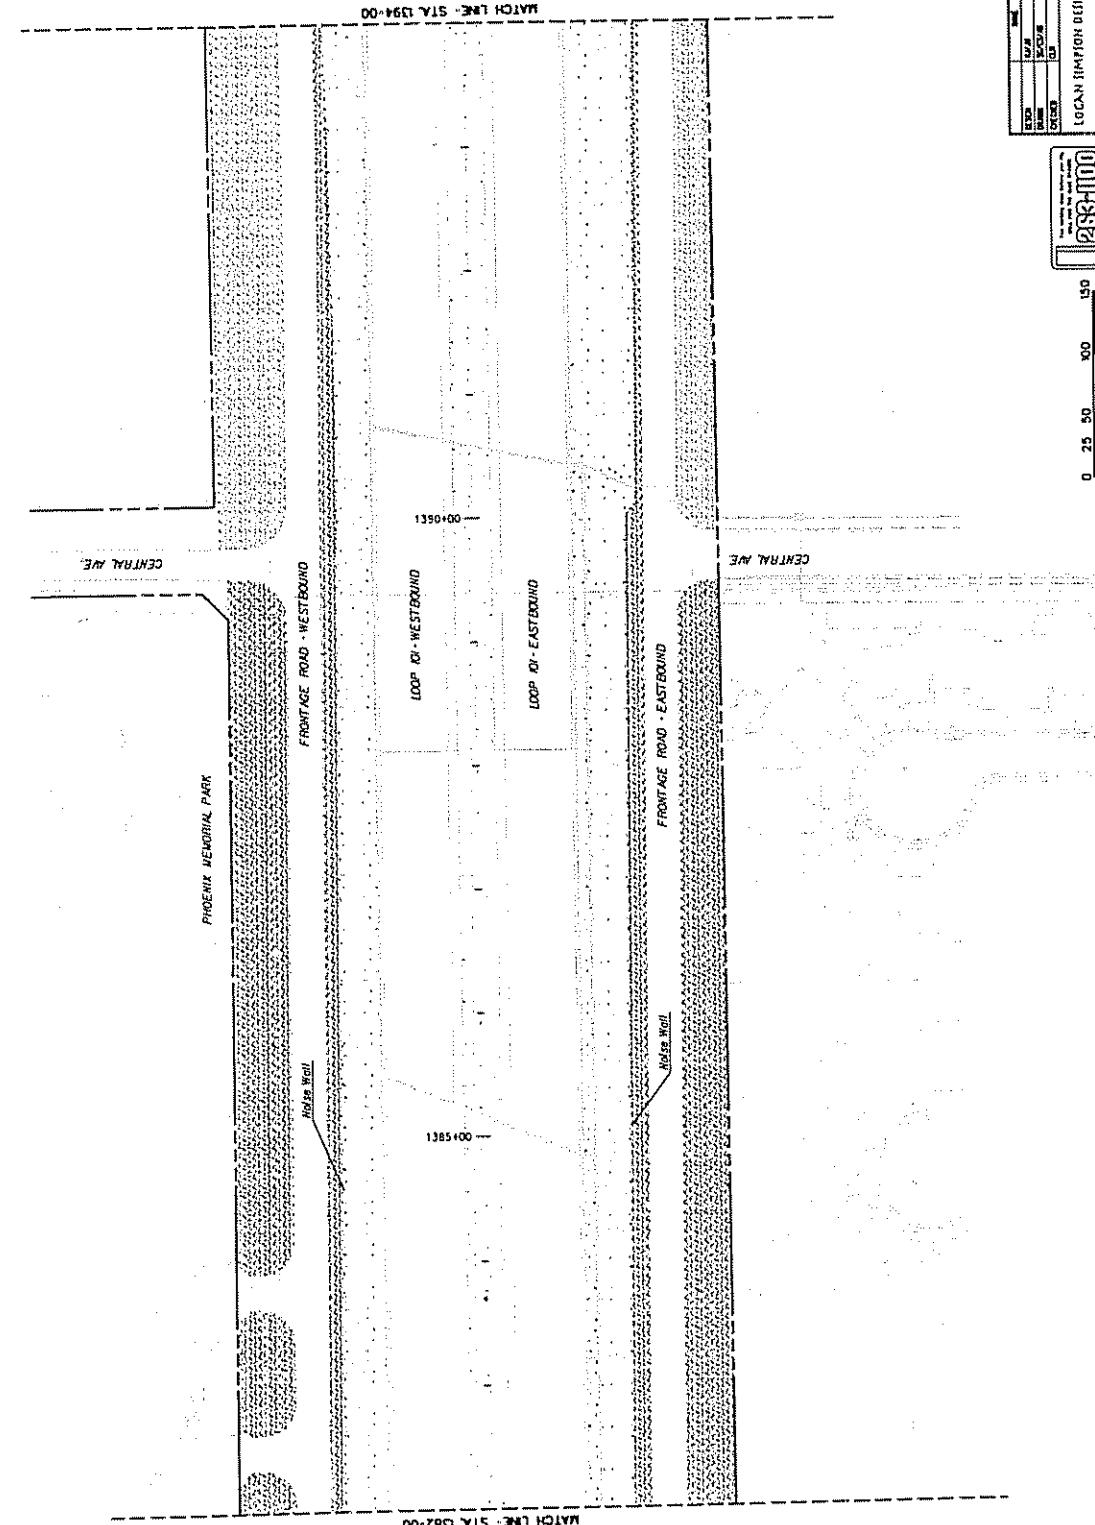

AQ1

| | |
|--|---------------|
| 941 CO 14 | |
| ARIZONA DEPARTMENT OF TRANSPORTATION | |
| INTERSTATE, TRANSPORTATION DIVISION | |
| ROADBED DEVELOPMENT SECTION | |
| THRU. MAINTENANCE ENRGT | |
| LOGAN SIMION DESIGN INC | |
| SR 101L 19TH AVENUE TO SCOTTSDALE ROAD | |
| TRACT NO H 4RD N 1C | RAM 600-1-567 |
| DRC No. 16-07 | |
| 7 APR 1971 | |



TRACT NO H 4RD N 1C RAM 600-1-567 DRC No. 16-07 7 APR 1971



SP4-00-1A
ARIZONA DEPARTMENT OF TRANSPORTATION
INTERSTATE TRANSPORTATION DIVISION
ROADBED DEVELOPMENT SECTION
FINAL MAINTENANCE DRAWING

DRPC No. 14-25
a REC 27



CITY OF PHOENIX
CITY PLANNING DEPARTMENT
CITY OF PHOENIX



LOGAN JIMION DESIGN INC
238-100
SR 101L
0 25 50 100 150

| TRANS | STATE | ROUTE NO. | POST MILE | TOTAL MILE |
|-------|-------|---------------|-----------|------------|
| 9 | ARIZ. | RAM 600-1-062 | 00.00 | 46.00 |
| | | DUL MA 024 | | |

MATCH LINE - STA 1394-00

140508

LOOP 101 - WESTBOUND

1400000

LOOP 101 - EASTBOUND

1395400

LOOP 101 - EASTBOUND

7TH ST. OFF RAMP EASTBOUND

7TH ST. OFF RAMP EASTBOUND

MATCH LINE - STA 1394-00

CORE CREEK WASH

Chin. Mt. East

FRONTAGE ROAD WESTBOUND

7TH ST. ON RAMP WESTBOUND

MATCH LINE - STA 1394-00


0

| | | | |
|------------|--------------|------------|--------|
| TRANS. NO. | PROJECT NO. | ROUTE TYPE | WEEK |
| 9 | RAM 6001-002 | REG | WEEKLY |
| | | | |

TOL. MA 024

MATCH LINE - SHEET 10 OF 47

MATCH LINE - STA. 100-00

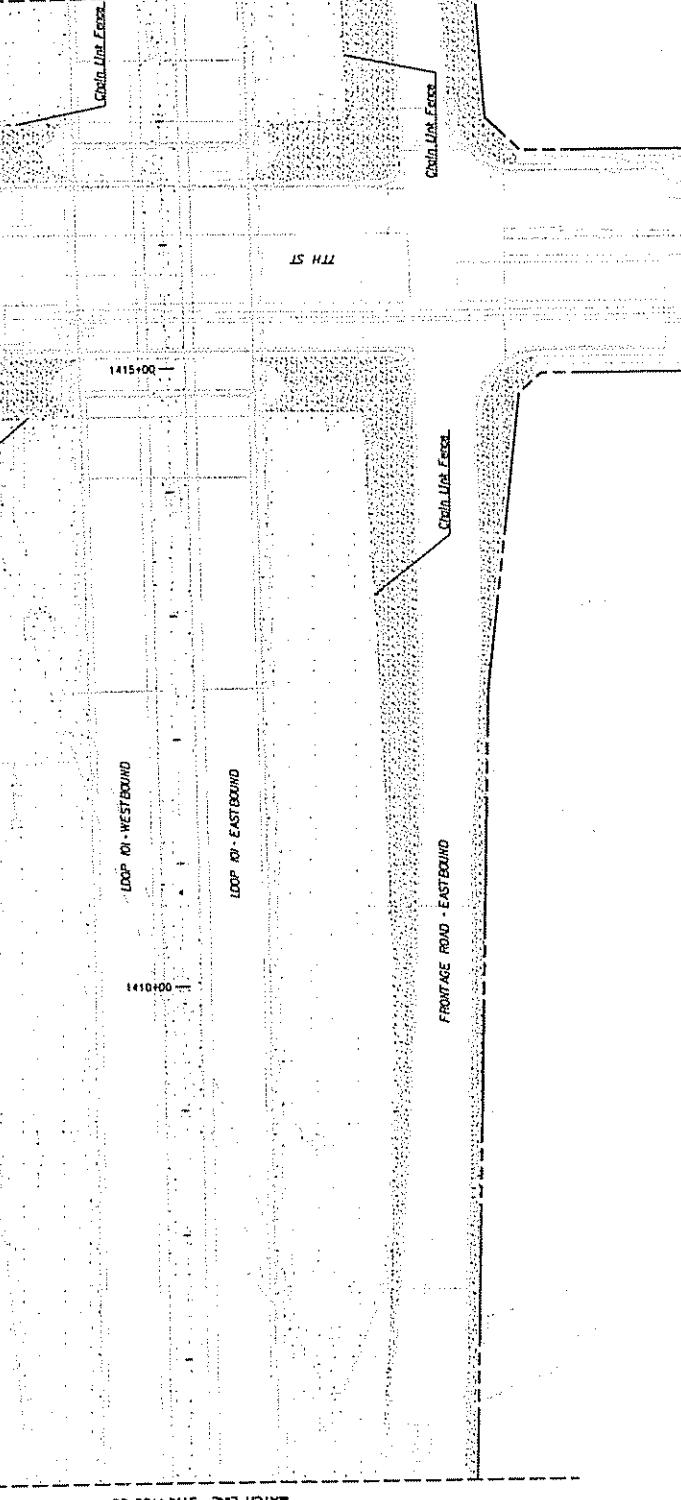

ADOT



PARK 0014



ARIZONA DEPARTMENT OF TRANSPORTATION
INTERSTATE TRANSPORTATION DIVISION
ROADBED DEVELOPMENT SECTION
FINAL MAINTENANCE DRAWING





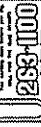

0 25 50 100 150

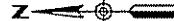

CITY OF PHOENIX

4001

MATCH LINE- SEE SHEET 11 OF 47

MATCH LINE- SEE SHEET 11 OF 47

MATCH LINE- SEE SHEET 9 OF 47

Grid Line Force



LOGAN MISSION DESIGN INC
19TH AVENUE TO SCOTTSDALE ROAD
SR 101L 150 100 50 0

PHOENIX, ARIZONA
DEPARTMENT OF TRANSPORTATION
INTERSTATE TRANSPORTATION DIVISION
ROADSIDE DEVELOPMENT SECTION
FRAUD MAINTENANCE DIVISION











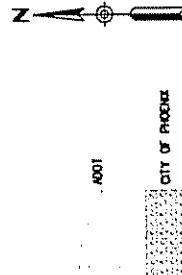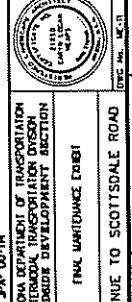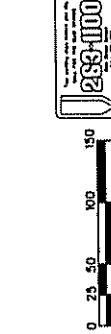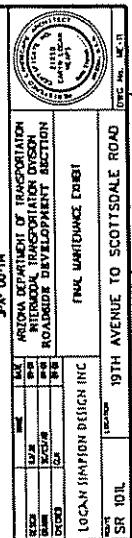

MATCH LINE - STA. 1418-00


MATCH LINE - SEE SHEET 10 OF 47

FRONTAGE ROAD - WESTBOUND

7TH ST. OFF RAMP - WESTBOUND



LOOP 1425-00

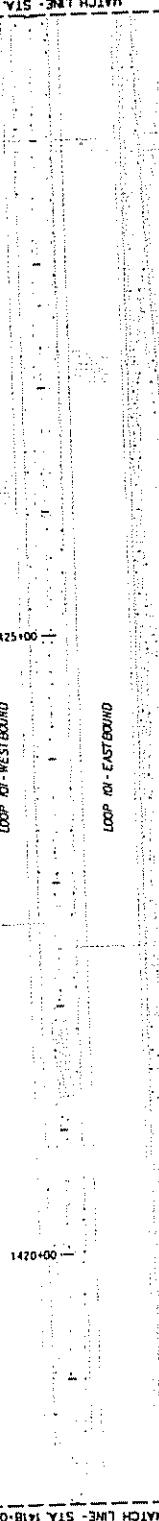

LOOP 1420-00

7TH ST. ON RAMP - EASTBOUND



Chain Link Fence

MATCH LINE - STA. 1418-00

| PARCEL NUMBER | PROJECT NO. | PCFS | TOTAL ACRES | % BMT |
|------------------|-----------------|------|----------------|-------|
| 9 | TRACS 600-1-552 | | | |

EDL MA 024

| | | | | |
|-----------|---------------|-------|------|------------|
| ROUTE NO. | PROJECT NO. | PERF. | TIME | RE. BY DAY |
| 9 | RAM 600-1-562 | | | KTL MA 074 |

SPK-00-14

| | | | | |
|-----------|------------------------------------|-------|------|------------|
| ROUTE NO. | PROJECT NO. | PERF. | TIME | RE. BY DAY |
| SR 101 | RAM 19TH AVENUE TO SCOTTSDALE ROAD | | | 001 |

ARIZONA DEPARTMENT OF TRANSPORTATION
INTERSTATE HIGHWAY
ROADBED DEVELOPMENT SECTION
FINAL MAINTENANCE DRAWING

LOGAN IMPERION DESIGN INC

0 25 50 100 150

CITY OF PHOENIX

001








TRACS NO. H 4830 03 C RAM 600-1-562 -- 12 of 47

| SECTION NUMBER | POINT NO. | POST MILE | ROAD NAME |
|-------------------|--------------|---------------|--------------|
| 9 | | RAM 600-1-562 | |
| | | 001 MA 074 | |



| | |
|---|-------------------------------------|
| CITY OF PHOENIX | |
| PAP-00-14 | |
| ARIZONA DEPARTMENT OF TRANSPORTATION INTERMODAL TRANSPORTATION DIVISION ROADBED DEVELOPMENT SECTION | |
| FINAL MAINTENANCE EXHIBIT | |
| SR 101L | 19TH AVENUE TO SCOTTSDALE ROAD |
| 0 25 50 100 150 | TRACS NO. H 4830 03 C RAM 600-1-562 |
| SPC NO. M.C.U. | 13 OF 47 |

MATCH LINE - STA 1442-00

MATCH LINE - STA 1442-00

FRONTAGE ROAD - WESTBOUND

LOOP RD - WESTBOUND

1450+00

1445+00

LOOP RD - EAST BOUND

FRONTAGE ROAD - EAST BOUND

Crown Line 202

A001



| | | | |
|------------|---------------|------------|---------------|
| ITEM NO. | ITEM NAME | ITEM NO. | ITEM NAME |
| 9 | RAM 600-1-042 | 9 | RAM 600-1-042 |
| XIL MA 074 | | XIL MA 074 | |

CITY OF PHOENIX
JPA-001H



0 25 50 100 150
SP. 10E 1500' 1500'

TRACS NO. H 4830 03 C RAM 600-1-052 TRACS NO. H 4830 03 C RAM 600-1-052 14 OF 47

MATCH LINE - STA 1468-00

MATCH LINE - STA 1454-00

FRONTAGE ROAD - WESTBOUND

1465+00

1460+08

1455+00

LOOP 101 - EASTBOUND

1465+00

1460+08

1455+00

FRONTAGE ROAD - EASTBOUND

Chain Link Fence



ADOT

CITY OF PHOENIX
JPA-001H








| | | | |
|--------------|---------------|------------|---------|
| TRANS. STATE | PROJECT NO. | SHIFT TIME | IN BALT |
| 9 | PAW 800-1-587 | 10A-10P | |
| TOL MA 024 | | | |

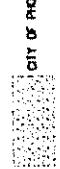


SP-00-14

| | | | |
|--------------|---------------|------------|---------|
| TRANS. STATE | PROJECT NO. | SHIFT TIME | IN BALT |
| 9 | PAW 800-1-587 | 10A-10P | |
| TOL MA 024 | | | |



.001

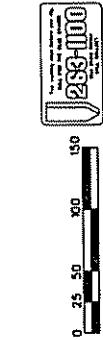

MATCH LINE STA. M78.00

1475

1470

LOOP 10 - EASTBOUND

Chain Link Fence

FRONTAGE ROAD - EASTBOUND

Note: N.E.

Chain Link Fence

19TH ST

Chain Link Fence


FRONTAGE ROAD - WESTBOUND

Chain Link Fence

MATCH LINE STA. M66.00

SP-00-14

| | | | |
|--------------|---------------|------------|---------|
| TRANS. STATE | PROJECT NO. | SHIFT TIME | IN BALT |
| 9 | PAW 800-1-587 | 10A-10P | |
| TOL MA 024 | | | |

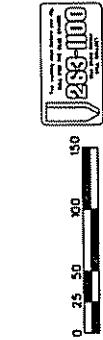



| | |
|-----------------------|--------------------------------------|
| SPAN 00-1H | ARIZONA DEPARTMENT OF TRANSPORTATION |
| TRACCS NO H 4810 03 C | STATE HIGHWAY DIVISION |
| | ROADBED DESIGN & DEVELOPMENT SECTION |
| | LOGAN STATION DESIGN INC |
| | FINAL MAINTENANCE ENTRI |

SPAN 00-1H
ARIZONA DEPARTMENT OF TRANSPORTATION
STATE HIGHWAY DIVISION
ROADBED DESIGN & DEVELOPMENT SECTION
LOGAN STATION DESIGN INC
FINAL MAINTENANCE ENTRI



23.00
100


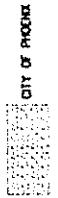


| | |
|-----------------------|--------------------------------------|
| CITY OF PHOENIX | |
| SPAN 00-1H | ARIZONA DEPARTMENT OF TRANSPORTATION |
| TRACCS NO H 4810 03 C | STATE HIGHWAY DIVISION |
| | ROADBED DESIGN & DEVELOPMENT SECTION |
| | LOGAN STATION DESIGN INC |
| | FINAL MAINTENANCE ENTRI |

CITY OF PHOENIX
SPAN 00-1H
ARIZONA DEPARTMENT OF TRANSPORTATION
STATE HIGHWAY DIVISION
ROADBED DESIGN & DEVELOPMENT SECTION
LOGAN STATION DESIGN INC
FINAL MAINTENANCE ENTRI


| TRANS. STATE | PROJECT NO. | PICT. NO. | TOTAL FT. | IN. BLK. |
|--------------|----------------|-----------|-----------|----------|
| 9 | TRAM 600-1-562 | RE | | |
| | SR. MA. 074 | | | |

TRANS. STATE
9
PROJECT NO.
TRAM 600-1-562
PICT. NO.
RE
SR. MA. 074

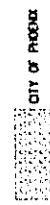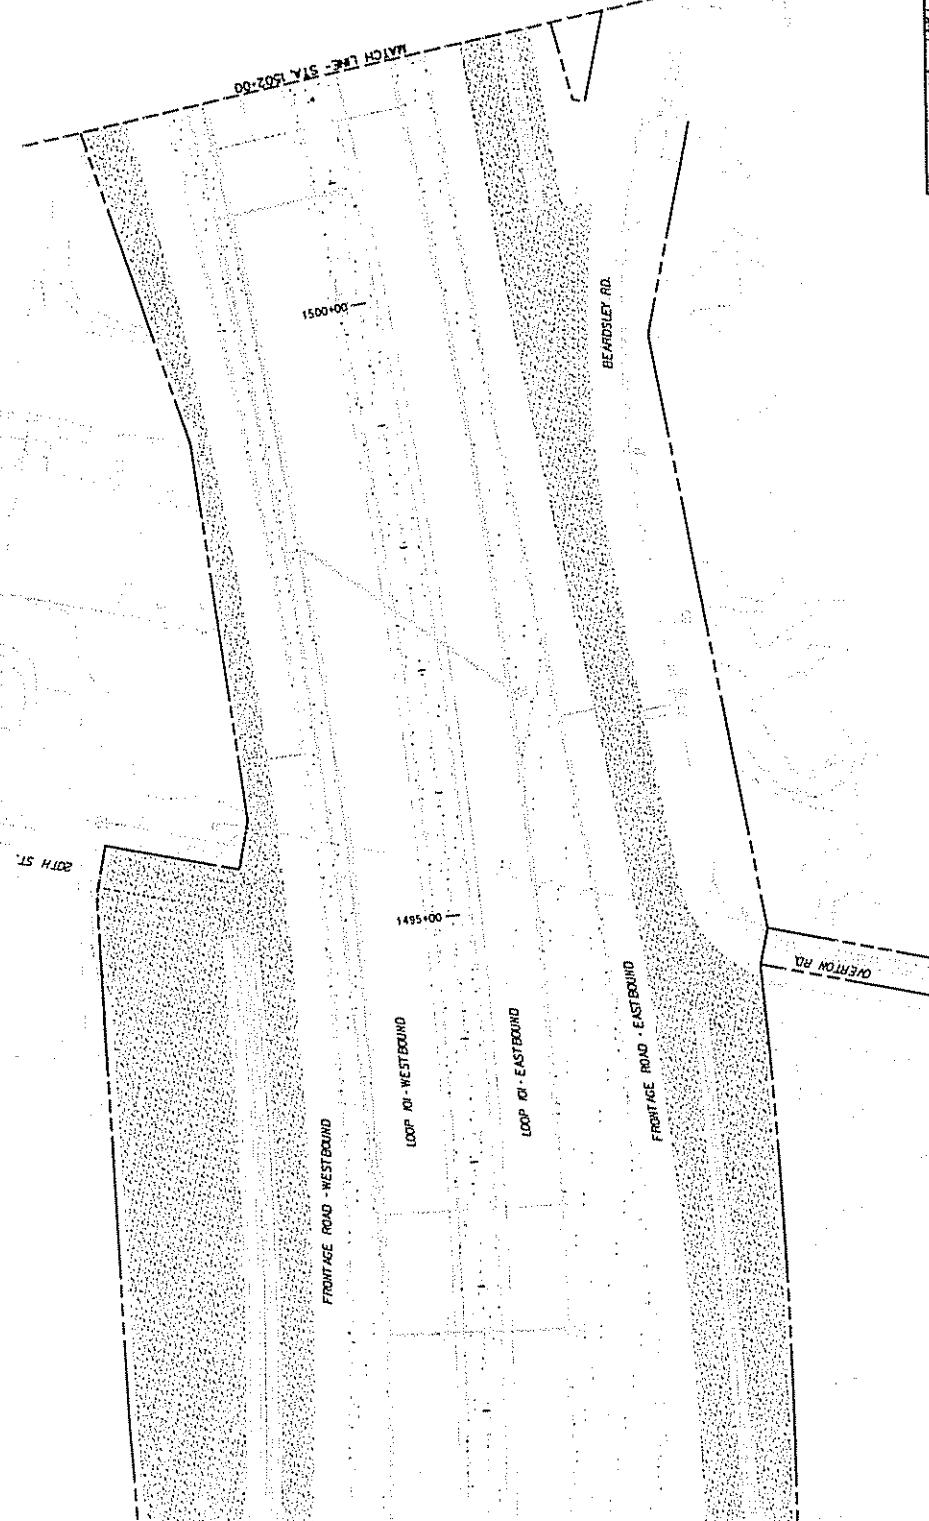

P&M-14

| | | |
|---------|--------------------------|------------------------------|
| STATE | ARIZONA | DEPARTMENT OF TRANSPORTATION |
| SECTION | INTERSTATE HIGHWAY | TRANSPORTATION DISTRICT |
| ROUTE | SR 101 | ROADS & BRIDGES |
| TYPE | GENERAL | ROUTE 101 |
| NAME | LOCAN SIMTION DESIGN INC | FINAL MAINTENANCE ENHBT |
| NUMBER | 233-100 | TRAM 1490-1-562 |


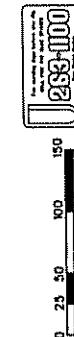


TRANS. STA 1490.00
C
TRAM 600-1-562
17 NOV 47



| TRANS. NO. | PROJECT NO. | PCFT. | TOTAL ACRES | ACRES IN S.A.T. |
|------------|----------------|-------|----------------|--------------------|
| 9 | TRAN 600-1-562 | | | |
| | DL MA 074 | | | |

TRANS. NO. 9 ARN 01 C TRAN 600-1-562 DATE: 11/20/2001 BY: JEFFREY M. HARRIS

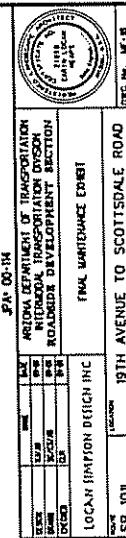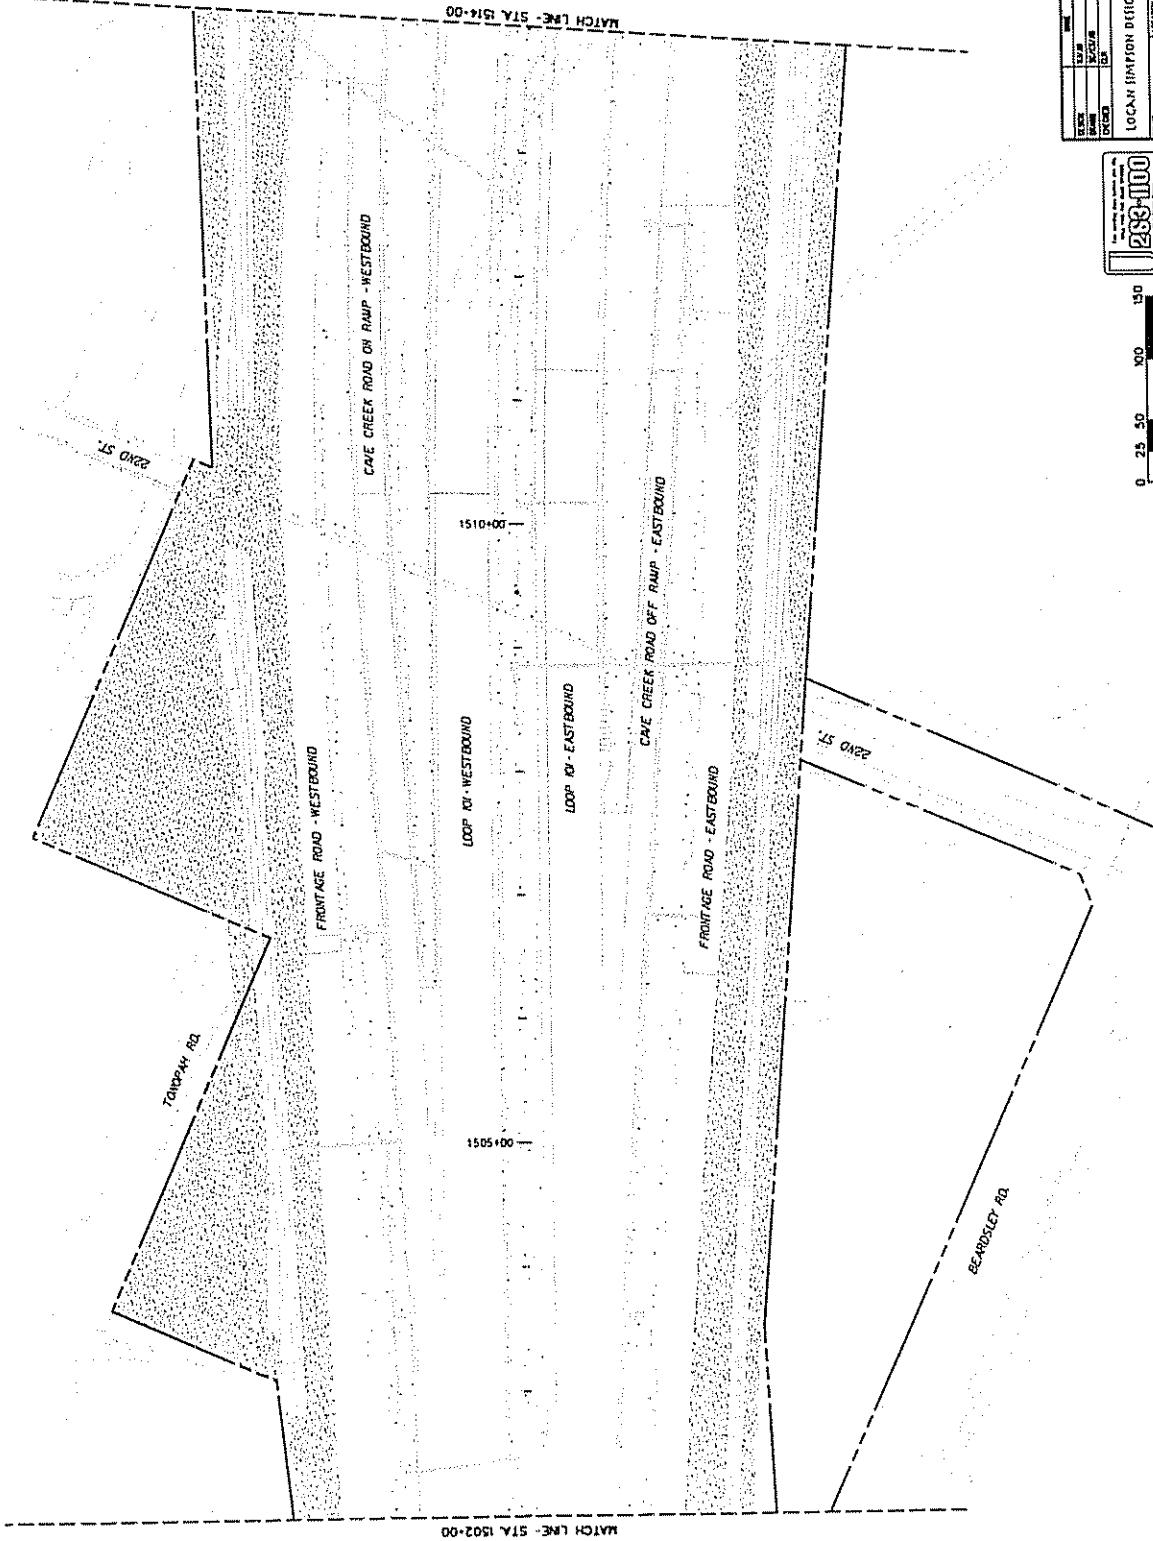


TRANS. NO. 9 ARN 01 C TRAN 600-1-562 DATE: 11/20/2001 BY: JEFFREY M. HARRIS

| FAIRA STATION | MARKET NO. | PIECE NO. | TOTAL AC. | # OF BLKS. |
|---------------|------------|---------------|-----------|------------|
| 9 | 9 | PIAM 6001-562 | | |
| | | 101L MA 024 | | |

1001

| | |
|---|---------------|
| PLAT NO. 14 | DATE NO. 47 |
| TRAC NO H 4840 U C | TRAC 6001-562 |
| CITY OF PHOENIX | |
| ARIZONA DEPARTMENT OF TRANSPORTATION INTERSTATE DIVISION ROADBED DEVELOPMENT SECTION 101 | |
| LOGAN HAMPTON DESIGN INC MAILING ADDRESS | |
| SR 101L SECTION 19TH AVENUE TO SCOTTSDALE ROAD | |

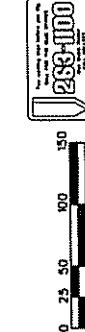

MATCH LINE - STA 1514-00

1515-00

1520-00

FRONTAGE ROAD - WESTBOUND

LOOP RD - EASTBOUND

FRONTAGE ROAD - EASTBOUND

Chain Link Fence

Chain Link Fence


CASE CENTER ROAD

MATCH LINE - STA 1523-00

1001

| ROUTE NUMBER | STREET NAME | PROJECT NO. | SECTION LENGTH | END DATE |
|--------------|--------------|-------------|----------------|----------|
| 9 | SR 500-1-M02 | | | |
| | 101 MA 024 | | | |



CITY OF PHOENIX
PLAT OF 1/4 SECTION
19TH AVENUE TO SCOTSDALE ROAD


PLAT 00-14

| | |
|---------------------------------------|-------------|
| ARIZONA DEPARTMENT OF TRANSPORTATION | |
| INTERSTATE TRANSPORTATION DIVISION | |
| ROADSIDE DEVELOPMENT SECTION | |
| SECTION | SIZE |
| 101 | 1/4 SECTION |
| 024 | 1/4 SECTION |
| DRAFT | |
| LOCAN SURVEYING INC | |
| TRAIL MAINTENANCE EXHB1 | |
| SR 101L 19TH AVENUE TO SCOTSDALE ROAD | |

SPC No. 5E-20
Twp 48 N R 11 E S 10 1/4 SEC 14




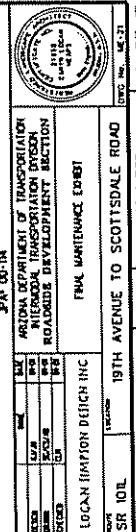

TRAFS NO H 4RDN DX C FAM 600-1-562 FAM 600-1-562
21 NOV 47



4001



MATCH LINE - STA 1548-00

1545+00

LOOP 101 • EASTBOUND
LOOP 101 • WESTBOUND

1540+00

CAVE CREEK ROAD ON RAMP • EASTBOUND

CAVE CREEK ROAD OFF RAMP • WESTBOUND

MATCH LINE - STA 1536-00

Chain Link Fence


ROTHWELL DR

| PROJECT NO. | PCIC. TOTAL. AC. | PCIC. SITES. AC. | IN. MALT. |
|-------------------------|---------------------|---------------------|-----------|
| 9 | PCIC. TOTAL. AC. | PCIC. SITES. AC. | IN. MALT. |
| 9 Int. FAM 600-1-562 | | | |

DTL WA 024

DATE INDEXED DRAWING NUMBER SHEET NUMBER

| | | | |
|---|-----------------|----------------|---------------|
| TRACT NO. | 4A 470 | RAM 6000-1-562 | TRC No. MC-22 |
| SECTION | 1 | 1 | 22 NC-27 |
| LINE | 28TH PL | | |
| TYPE | SCOTTSDALE ROAD | | |
| MAINTENANCE EXHIBIT | 288-100 | | |
| ARIZONA DEPARTMENT OF TRANSPORTATION INTERSTATE TRANSPORTATION ROADS AND DEVELOPMENT SECTION ROUTE 288 | | | |
| LOCAN SIMONSON DESIGN INC | | | |

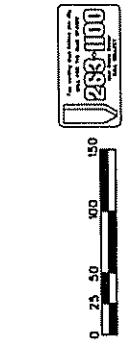

.4001

MATCH LINE STA 1560-00

1555+00

LOOP 101 • EASTBOUND

150+055

LOOP 101 • WESTBOUND

MATCH LINE STA 1560-00

WILDFIRE LN

28TH ST

HOMMEGA DR.

| PARCEL NUMBER | PARCEL TOTAL | PARCEL METERS | PARCEL MILES |
|---------------|----------------|---------------|--------------|
| 9 | RAM 8001-1-562 | | |
| | | | |
| TOL MA 024 | | | |


PHOENIX METRO AREA



SPY 00-1H

CITY OF PHOENIX



0 25 50 100 150

MATCH LINE STA 1572-00
TRAC NO. H 4830 03 C RAM 600-1-562 DATE 04/01/04

100



MATCH LINE STA 1572-00

1570-00

1565-08

LOOP 10 • WESTBOUND

LOOP 10 • EASTBOUND

MATCH LINE STA 1560-00













| TRANS. NO. | TRANS. DESC. | PROJECT NO. | PERC. TOTAL | IN RAIL |
|------------|----------------|-------------|-------------|---------|
| STATION | SECTION | REC'D. | REC'D. | REC'D. |
| 9 | RAIL 800-1-562 | | | |
| | TOL MA 024 | | | |

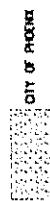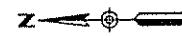

SPK 00-14

| |
|--------------------------------------|
| ARIZONA DEPARTMENT OF TRANSPORTATION |
| INTERSTATE TRANSPORTATION DIVISION |
| ROADSIDE DEVELOPMENT SECTION |
| ROUTE 101 |
| TRAIL MAINTENANCE DRAFT |
| LOJAN JIMMIE DITCH INC |

SR 101E Located 19TH AVENUE TO SCOTTSDALE ROAD

SPK No. 00-14





0 25 50 100 150

MAATCH LINE - STA 1585.00


LOOP 101 - WESTBOUND

1572.00

1575.00 —

LOOP 101 - EASTBOUND

1575.00 —

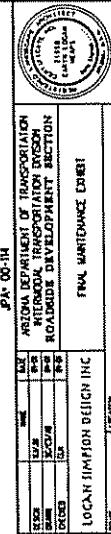


PAI-0014

TRAC NO H 4TH 01 C

RAM 600-1-562

DPC NO. 4C-23

DR NO. 4C-27

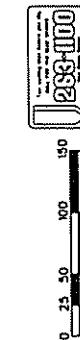


238-110

SR 101L

0 25 50 100 150

CITY OF PHOENIX
PLATINUM PLATE
RECEIVED
JULY 1997

A901

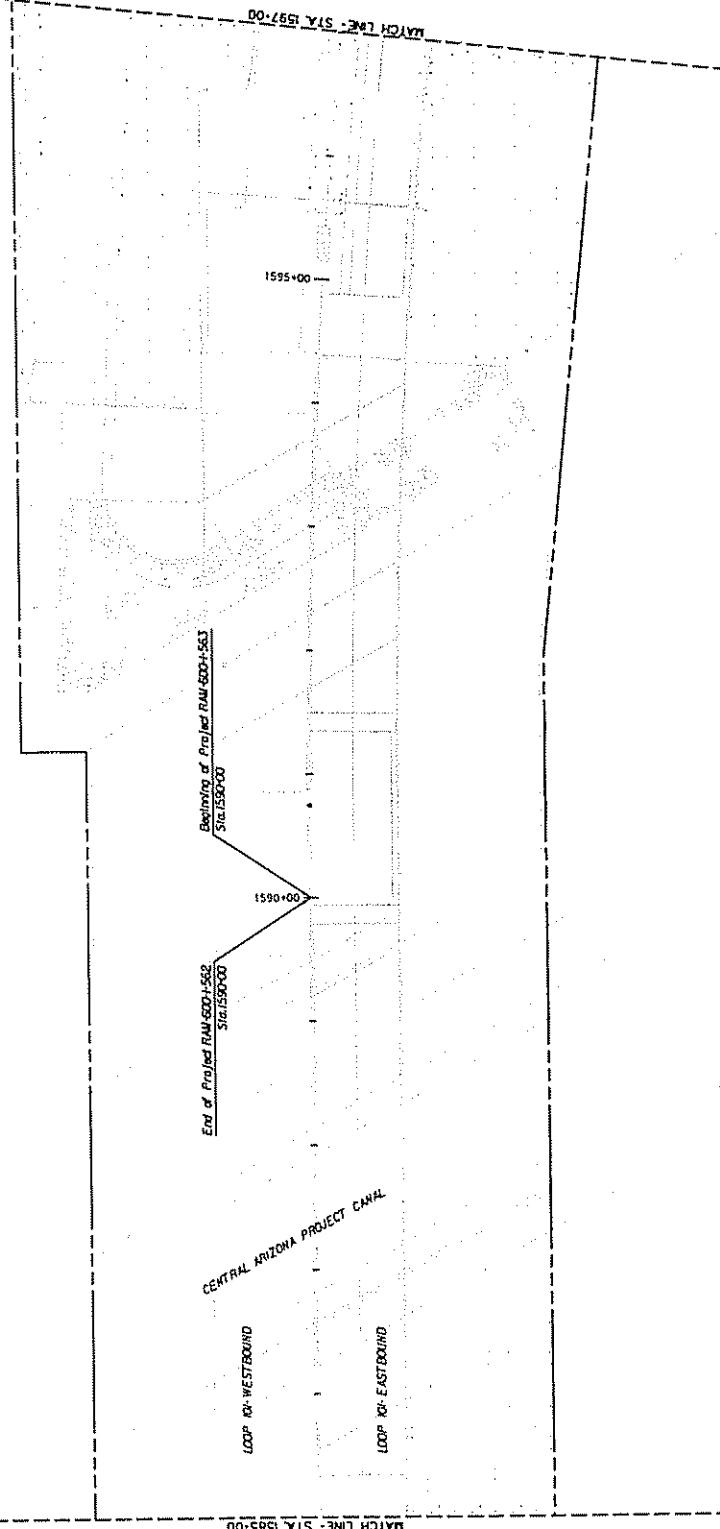

| SECTION | STATION | PROJECT NO. | DIST. TOTAL. IN. | WHEEL IN. | W. GAGE |
|---------|---------------|-------------|---------------------|--------------|---------|
| 9 | RAM 600-1-562 | | | | |
| | RAM 600-1-563 | | | | |

RIL MA 014
RIL MA 019



SP-001H


PHOENIX DESIGN & DEVELOPMENT
LORAN HAMPTON DESIGN INC

PHOENIX, ARIZONA
CITY OF PHOENIX

TRACS NO. H 4B45 03 C RAM 6001-563

DATE: 10/10/01

265 OF 47



MATCH LINE - STA 1597.00

MATCH LINE - STA 1609.00

1600.00

LOOP 101 - EASTBOUND

1600.00

LOOP 101 - WESTBOUND

1605.00



SR 101 MA 070

| TRANS | STRETCH | PROJECT NO. | SPAN | TYPE | DATE | INCHES | MM | INCHES | MM |
|-------|---------|----------------|------|------|------|--------|----|--------|----|
| 9 | REC | TRAM 600-1-563 | | | | | | | |

TOL MA 02B




JK-0014

| | | |
|---------|--------|--------------------------------------|
| TRANS | REC | ARIZONA DEPARTMENT OF TRANSPORTATION |
| STRETCH | SCOTT | INTERSTATE TRANSPORTATION DIVISION |
| SECTION | 0A | ROADSIDE DEVELOPMENT SECTION |
| ROUTE | SR 10E | FINAL WARTIME EARTH |

LOCAN TIMING DESIGN INC

TRAC NO H 4845 03 C TRAM 600-1-563

DMC No. JK-014
27 NOV 27

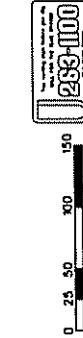

MATCH LINE STA 1621-00

1620-00

1615-00

00-0191

MATCH LINE STA 1509-00

LOOP 107 - WEST BOUND

1620-00

1615-00

4001



CITY OF PHOENIX

4001

TRAC NO H 4845 03 C TRAM 600-1-563

27 NOV 27

| NAME | STATE | SECTION | PROJECT NO. | PACIFIC TOTAL MILES | IN MILE |
|----------------|---------|------------|-------------|------------------------|---------|
| 9 | ARIZONA | 8001-1-543 | | | |
| SR 101, MA 070 | | | | | |




CITY OF PHOENIX

| | |
|--------------------------------------|----------|
| PLAT 00-114 | |
| ARIZONA DEPARTMENT OF TRANSPORTATION | |
| INTERSTATE TRANSPORTATION DIVISION | |
| PHOENIX DEVELOPMENT SECTION | |
| FINAL MAINTENANCE DRAWING | |
| LOCAN THOMPSON DESIGN INC | |
| MAILED | RECEIVED |
| 10/10/01 | 10/10/01 |
| TRACT NO. H 414-01 C | |
| RAIL RD#1-561 | |
| SCOTTSDALE ROAD | |
| 19TH AVENUE TO SCOTTSDALE ROAD | |

DRAFT NO. 4C-10

DATE NOV 10 2001

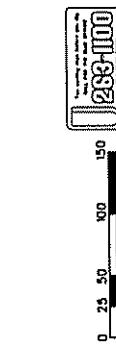

MATCH LINE STA 1621-00

1625+00

LOOP 101 - WESTBOUND

MATCH LINE STA 1633-00

1630+00


LOOP 101 - EASTBOUND

A001




PLAT 00-114

| TABLE NUMBER | STREET NAME | PROJECT NO. | SECTION NO. | TOTAL ACRES | ACRES SWEET |
|-----------------|----------------|----------------|----------------|----------------|----------------|
| 9 | SR 101L | ADP 1000-1-543 | 1 | .000 | |
| | | | | 101L MA 079 | |

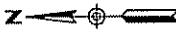

MAP 00-15
ARIZONA DEPARTMENT OF TRANSPORTATION
INTERSTATE TRANSPORTATION DIVISION
ROADSIDE DEVELOPMENT SECTION
DIVISION OF HIGHWAYS
FINAL MAINTENANCE EXHIBIT

| | |
|-----------|--------------------------------|
| MAP 00-15 | DATE 07-15-01 |
| SR 101L | SECTION 150 |
| 12SKH100 | 19TH AVENUE TO SCOTTSDALE ROAD |

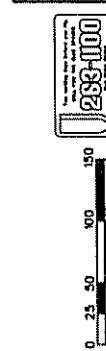

TRAFFIC MNT H AREA 079 RAI 800-1-543 DATE 07-15-01

| ROUTE | STREET | PROJECT NO. | ROUTE TOTAL MILES | MILE |
|-------|----------------------|-------------|----------------------|------|
| 9 | MAIN ROAD 6001-1-563 | | | |

TRL MA 029

MATCH LINE - STA 1857.00

1655.00

LOOP 101 WESTBOUND

1650.00

LOOP 101 EASTBOUND

MATCH LINE - STA 1845.00

A01

CITY OF PHOENIX

201-001H

| |
|--------------------------------------|
| ARIZONA DEPARTMENT OF TRANSPORTATION |
| INTERSTATE TRANSPORT DIVISION |
| ROADBED DEVELOPMENT SECTION |
| ROUTE 101 |
| FINAL MAINTENANCE EXHIBIT |
| LOGAN DIVISION REICHL INC |
| SR 101L |
| 19TH AVENUE TO SCOTTSDALE ROAD |

DRAFT NO. 4 ARAS 07/7/71 DRAFT EDITION 1-557-1 DRAFT NO. 2




201-001H
0 25 50 100 150

ROUTE 101

| PARCEL NUMBER | PARCEL ID | SECTION | ROW | SHOT | RE-SHOT |
|---------------|---------------|---------|-----|------|---------|
| 9 | TRAM 6001-003 | 100 | 100 | | |
| | 101 MA 029 | | | | |

MATCH LINE - STA 1657-00

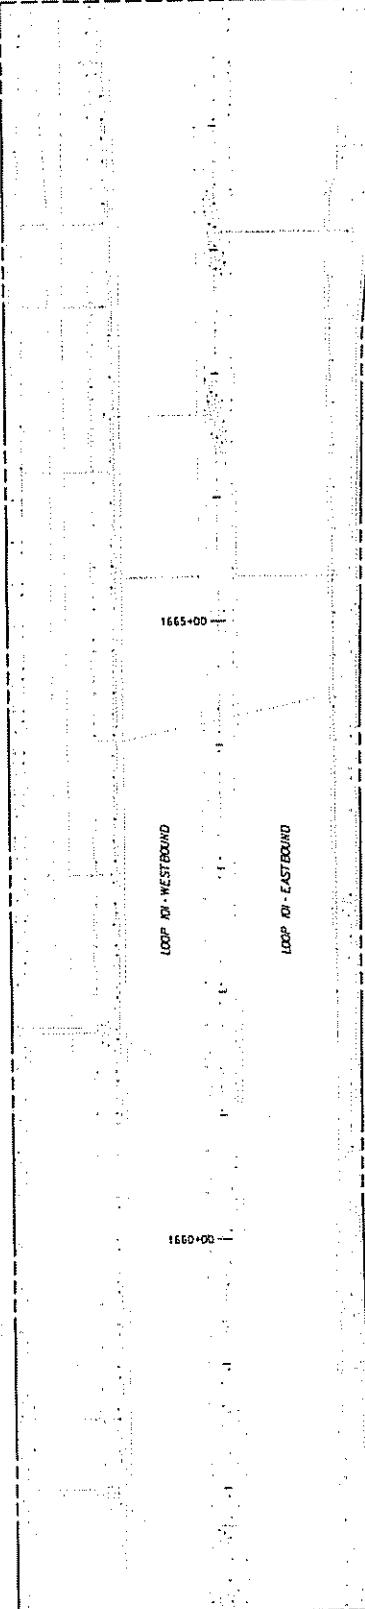

MATCH LINE - STA 1657-00



SPK-00-14


ARIZONA DEPARTMENT OF TRANSPORTATION
INTERSTATE TRANSPORTATION DIVISION
ROADBED DESIGN SECTION
FINAL MAINTENANCE DRAWING

19TH AVENUE TO SCOTTSDALE ROAD

TRAFFIC NO. 4445 DT 1 TRAM 601-1-551






| ROUTE | STATE | PROJECT NO. | ROUTE LENGTH | ROUTE MILE |
|-------|---------|---------------|--------------|------------|
| 9 | ARIZONA | FM 1600-1-543 | MILES | 0.00 |

19TH MA 019



A001



PAK 001-14


19TH AVENUE TO SCOTTSDALE ROAD

Spec. No. MR-32 Date 5/27/91

PHOENIX, ARIZONA

ARIZONA DEPARTMENT OF TRANSPORTATION
INTERSTATE TRANSPORTATION DIVISION
ROADSIDE DEVELOPMENT SECTION








MATCH LINE STA 1683.00

1680.00

1675+00

1670.00

1660.00

MATCH LINE STA 1670.00

19TH AVENUE TO SCOTTSDALE ROAD

FM 1600-1-543

SPEC. NO. MR-32 DATE 5/27/91

27

| PROJECT NO. | PCN | TOTAL AC. | AC. WATER | AC. BAI |
|-------------|--------------|--------------|--------------|------------|
| 9 | RAM 6001-543 | | | |
| | MR. MA 019 | | | |




CITY OF PHOENIX


JPA 001



| | |
|---|--------------------------------|
| JPA 001 | |
| ARIZONA DEPARTMENT OF TRANSPORTATION INTERSTATE TRANSPORTATION DIVISION ROADWAY DEVELOPMENT DIRECTORATE PHOENIX, ARIZONA | |
| FINAL MAINTENANCE EXHIBIT | |
| TRACES NO. H 4B45 03 C RAM 6001-543 | |
| SCOTTSDALE ROAD | |
| SR 101L | 19TH AVENUE TO SCOTTSDALE ROAD |
| DRAFT NO. UC-125 | |

MAP NO. 47

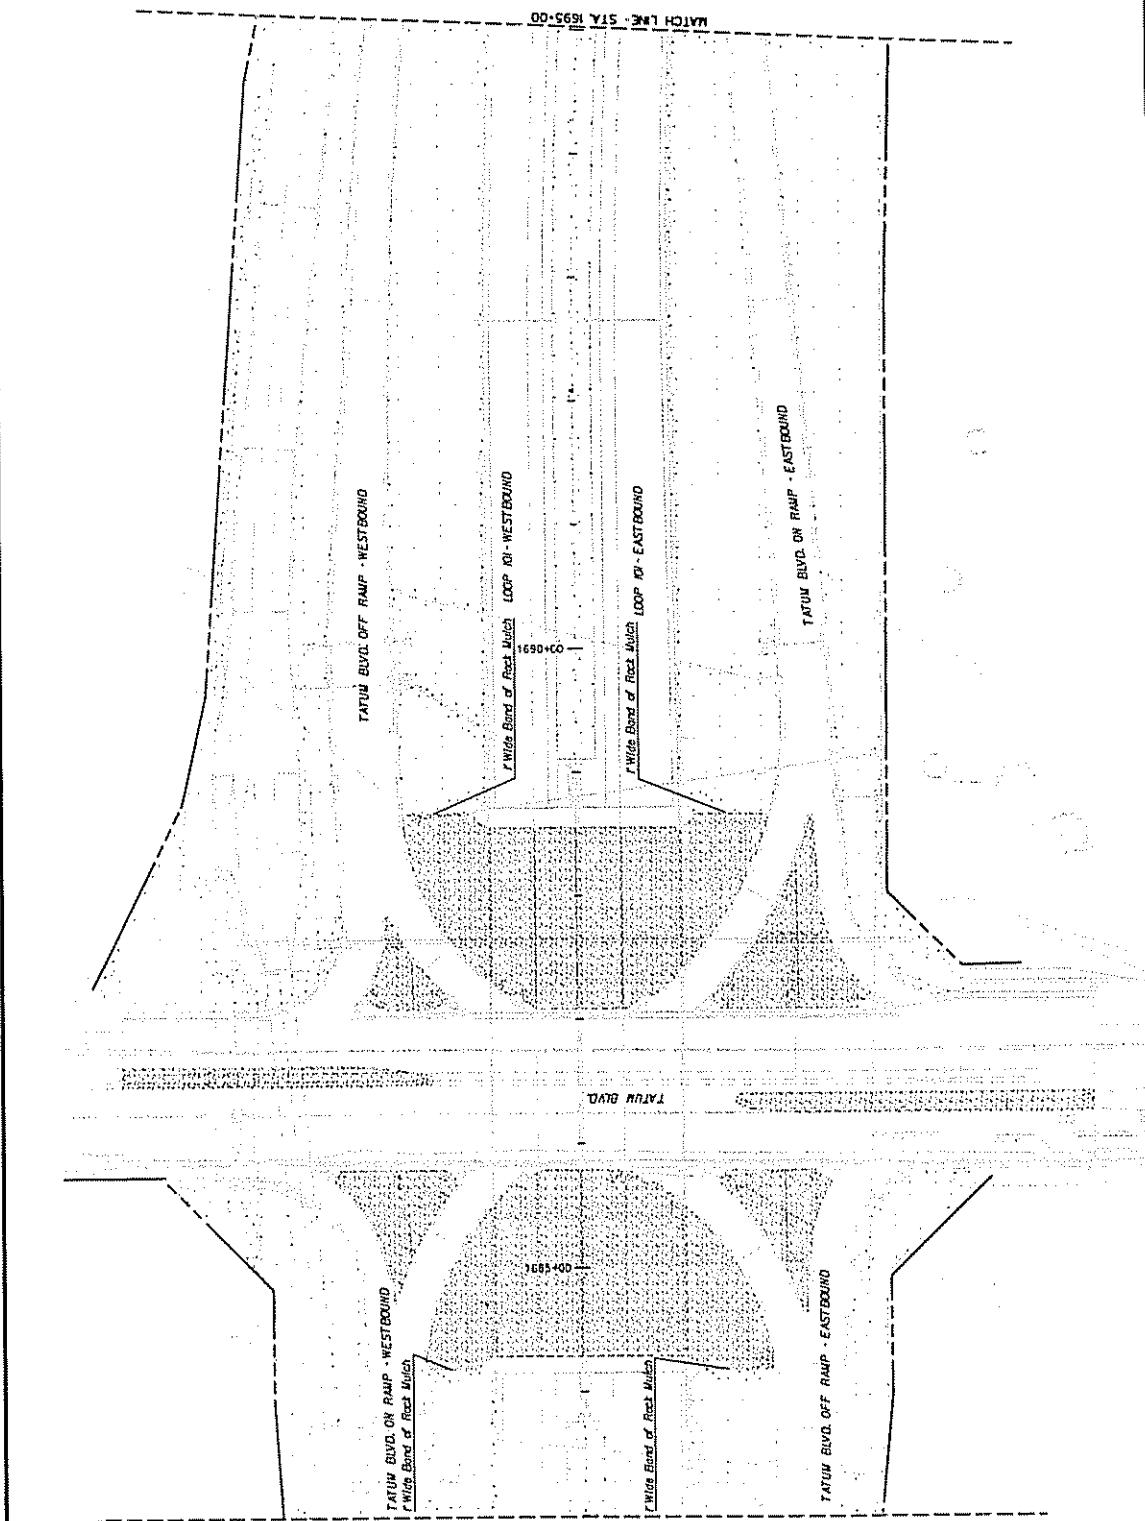


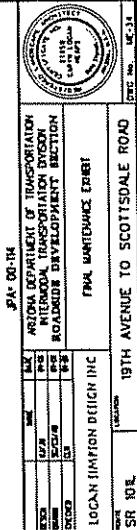

CITY OF PHOENIX
APR 01 14



| ROUTE | START | END | ROUTE NO. | ROUTE TYPE | MI. EAST | MI. WEST |
|-------|-----------------|-----------------|-----------|------------|----------|----------|
| 9 | MI. 1000.0+00.0 | MI. 1000.1+50.0 | | | | |
| | TRL MA 079 | | | | | |

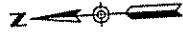

APR 01

MATCH LINE STA 1707.00

1705+00

00-0001
LOOP 10 - WESTBOUND


TATUM BLVD. ON RAMP - EASTBOUND

1705+00
LOOP 10 - EASTBOUND

TATUM BLVD. - EAST

MATCH LINE STA 1695.00

0 25 50 100 150

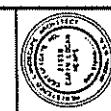

CITY OF PHOENIX
PLAT

SPK 00-14

ARIZONA DEPARTMENT OF TRANSPORTATION
INTERSTATE DIVISION
ROADSIDE DEVELOPMENT SECTION
ROUTE 101
FINAL MAINTENANCE EXHIBIT

DATE NO. 47-35

DATE NO. 47-35



TRAFFIC LANE II AREA AT 19TH AVENUE TO SCOTTSDALE ROAD
SR 101
0 25 50 100 150

MATCH LINE STA 1707-00

1710-00

1715-00

LOOP 101 - WEST BOUND

LOOP 101 - EAST BOUND



MATCH LINE STA 1709-00

| SECTION | PROJECT NO. | PILOT | TYPE | NAME |
|-----------|-----------------|-------|------|-------------|
| SECTION 9 | Proj 6001-1-MAS | 9 | TYPE | NAME |
| | | | | KIRL MA 029 |

#001



101, 1A 079

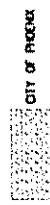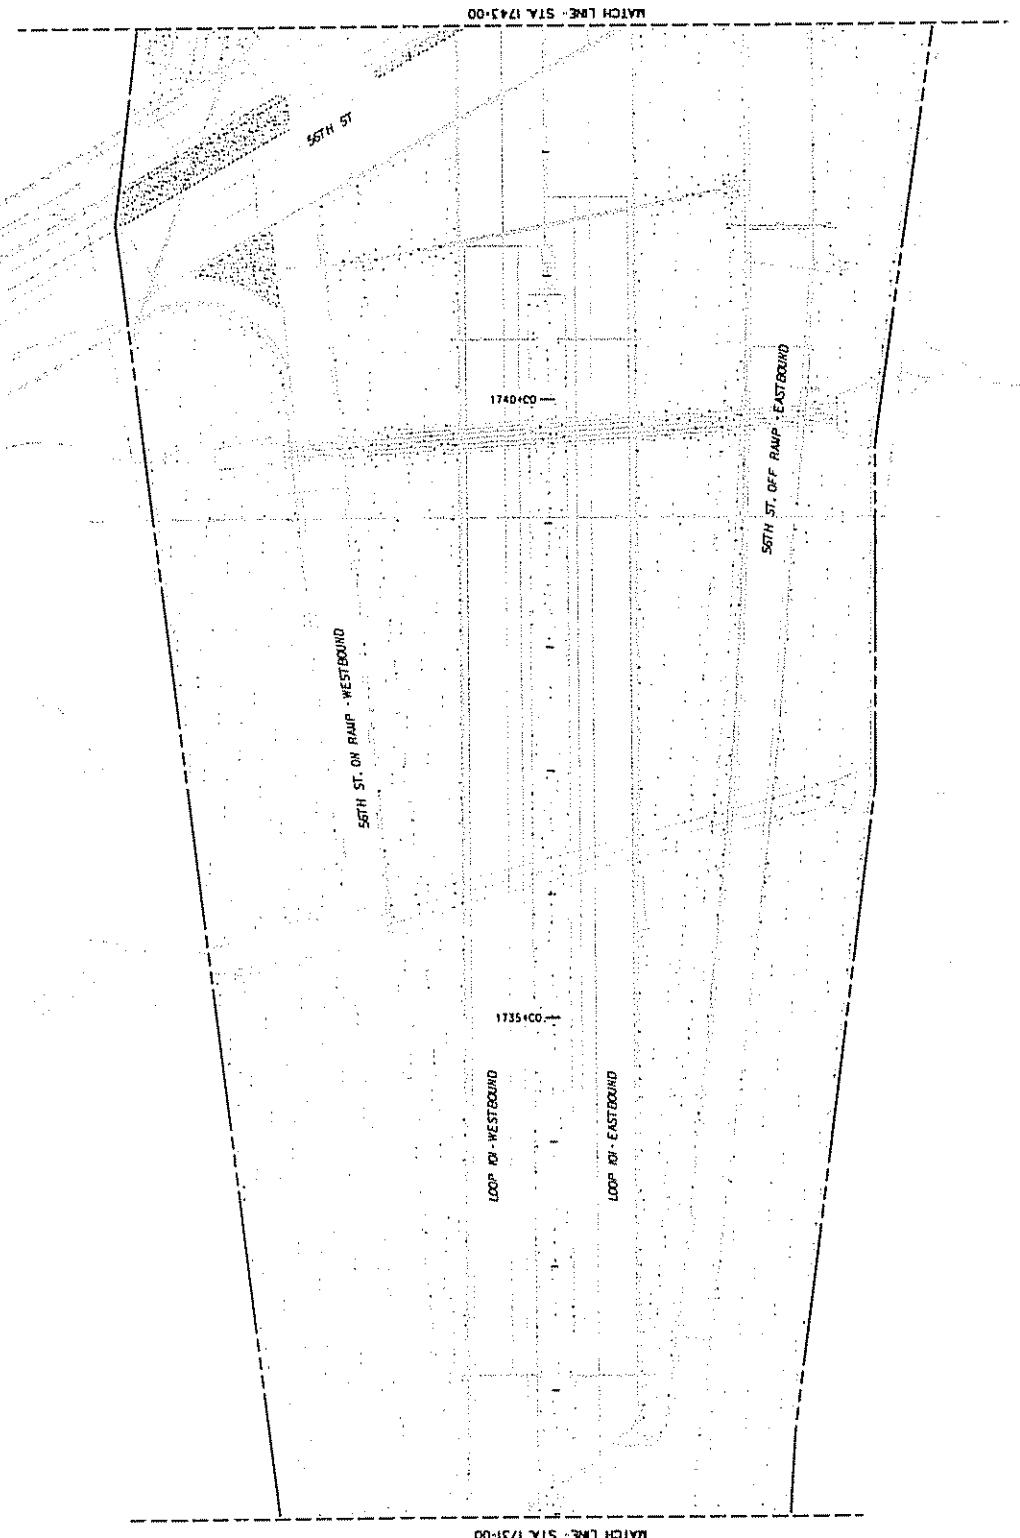

1001

SEK 001A

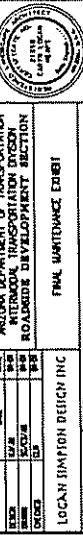

0 25 50 100 150

SR 101L

19TH AVENUE

SCOTTSDALE ROAD

TRAITS N H 4R45 03 C RAM 801-1-563







| | | | |
|--------------|------|------|-----------|
| PROJECT NO. | PCCT | TYPE | IN S.A.T. |
| 9 | PCCT | TYPE | IN S.A.T. |
| RAM 6001-543 | | | |

NFL MA 0270

MATCH LINE STA 1755+00

MATCH LINE STA 1755+00

MATCH LINE STA 1755+00

56TH ST. OFF RAMP - WESTBOUND

1750+00


1745+00

LOOP 10 - EASTBOUND



56TH ST. ON RAMP - EASTBOUND

56TH ST.

4001

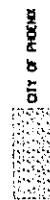

SP-00-TH

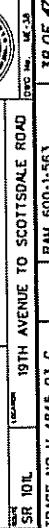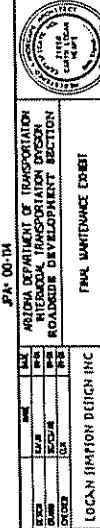

NOTE: MAINTENANCE RESPONSIBILITY EXTENDS SOUTH
TO EXISTING MEDIAN.



LOGAN HAMPTON DESIGN INC

PAUL WATKINS, EDER

SR 101C

19TH AVENUE TO SCOTTSDALE ROAD

TRACS NO. H 4845 03 C

RAM 6001-563

38 OF 47



ARIZONA DEPARTMENT OF TRANSPORTATION
INTERSTATE DIVISION
ROADWAY DESIGN SECTION
ROUTE 101
LOGAN HAMPTON DESIGN INC
SR 101L 19TH AVENUE TO SCOTTSDALE ROAD



JPN 00114



.0001

CITY OF PHOENIX

MATCH LINE - STA 1755-00

56TH ST. OFF RAMP - WESTBOUND

1750+00

00+5911

MATCH LINE - STA 1767-00

LOOP 101 - EASTBOUND

100

00

00

| TRANS. STATE | PROJECT NO. | TRANS. ID | TOTAL MILE | MILE | MI. RATE |
|--------------|----------------|-----------|---------------|------|----------|
| 9 | JANM 800-1-503 | | | | |

101 MA 019

MAP 00-14


| | |
|--------------------------------------|--|
| ARIZONA DEPARTMENT OF TRANSPORTATION | |
| INTERSTATE TRANSPORTATION DIVISION | |
| ROADSIDE DEVELOPMENT SECTION | |
| ROUTE 101 | |
| TRAIL MAINTENANCE EDITOR | |

LOGAN SIMION DESIGN INC

SR 101L

MAPS AND AREAS FOR TRAIL ROUTE 101

CITY OF PHOENIX

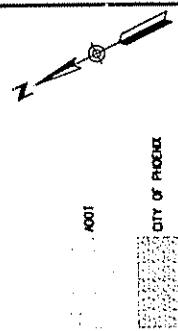

4001

MARK LINE STA 1767-00

MARK LINE STA 1779-00

1775-00

1776-00

LOOP 101 - WESTBOUND


LOOP 101 - EASTBOUND




MAPS AND AREAS FOR TRAIL ROUTE 101

| | | | |
|--------------|----------------|-------------|------------|
| TRANS. STATE | PROJECT NO. | PERMIT TYPE | PERMIT NO. |
| RECD: | TRAM 600-1-563 | NO | |
| 9 | REC'D. | | |

TRM MA 07B

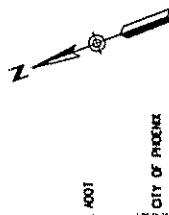


N

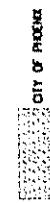

SP-0014

| | | | |
|---|--------------------------------|-------------|--------------------------------|
| ARIZONA DEPARTMENT OF TRANSPORTATION INTERSTATE TRANSPORTATION DIVISION ROADSIDE DIVISION SECTION | | | |
| FINAL MAINTENANCE DIRECT | | | |
| DATE | PERM. NO. | PERMIT TYPE | PERMIT NO. |
| EXPIRES | SR 101 | NO | SR 101 |
| ISSUED | 19TH AVENUE TO SCOTTSDALE ROAD | NO | 19TH AVENUE TO SCOTTSDALE ROAD |
| FOR WHOM ISSUED | LOCAN SIMTION DESIGN INC | NO | LOCAN SIMTION DESIGN INC |
| TO WHOM ISSUED | 233-100 | NO | 233-100 |

TRACT NO. H 4R45 N 3 C TRAM 600-1-563 At / 10-17

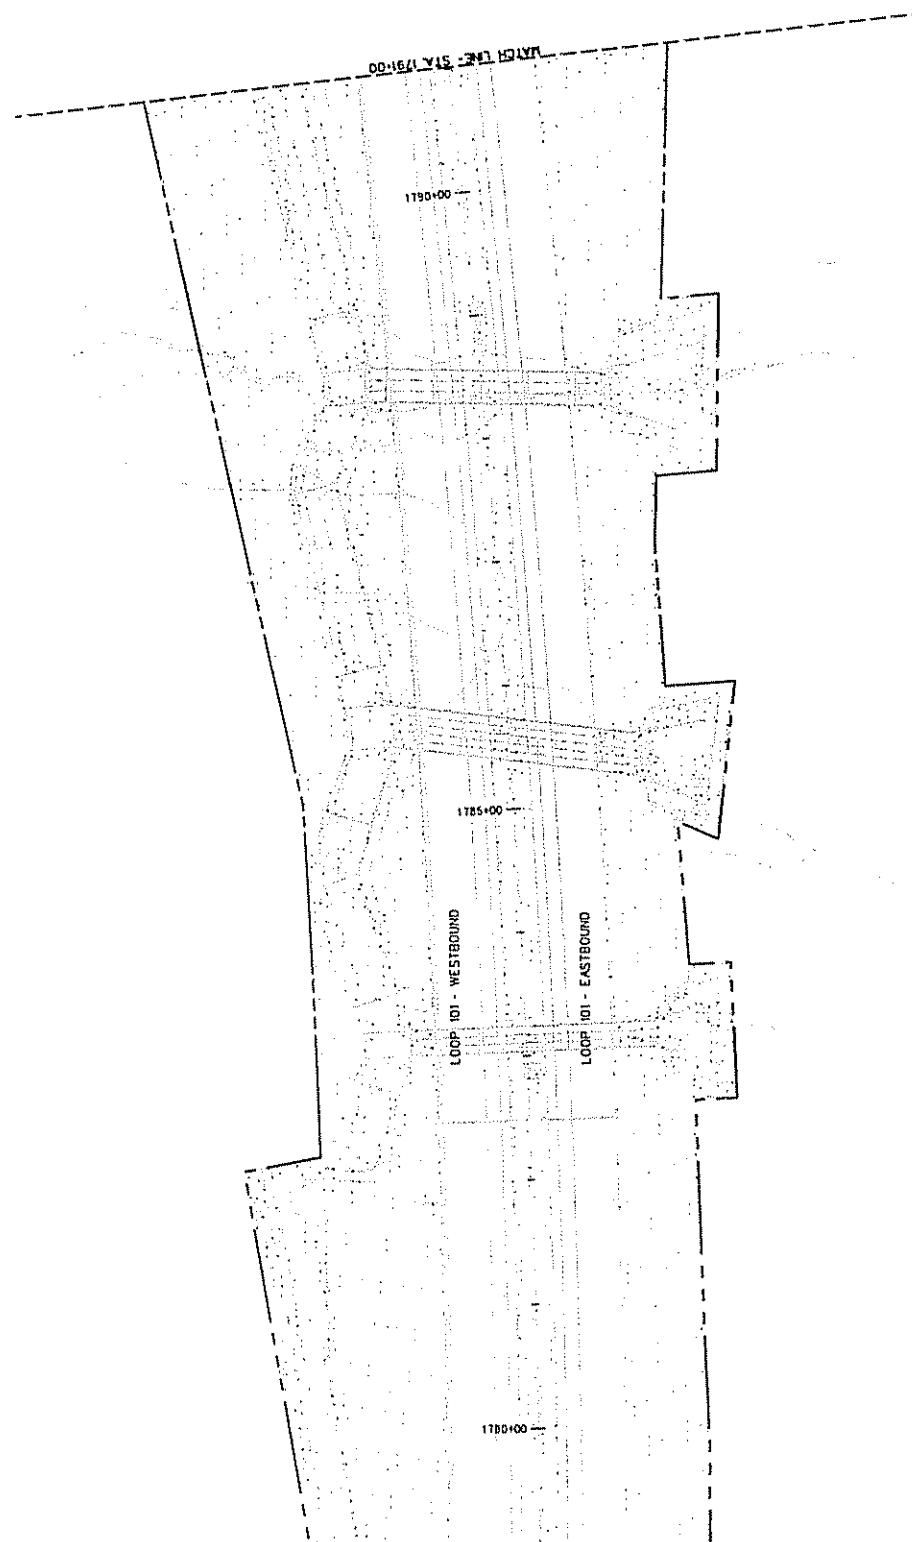

| NAME | STREET | PROJECT NO. | PERMIT NO. | DATE | AS BUILT |
|------|--------|---------------|------------|------|----------|
| 9 | mt. | RAM 600-1-563 | | | |

SRZ MA CTB

4

5

MATCH LINE STA 1803-00

1181000

LOOP FOR WESTBOUND

1795-00

LOOP FOR EASTBOUND

MATCH LINE STA 1791-00

4001



SPK 00-114


SRZ 10L 283100

TRACS NO. H 4845 03 C RAM 600-1-563
TRACS NO. H 4845 03 C RAM 600-1-563
42 OF 47

| | | | | |
|--------|-------|---------------|------------|-------------|
| TABLE | STATE | PROJECT NO. | PERMIT NO. | PERMIT DATE |
| ACTION | | RAM 600-1-563 | | |
| 9 | PERM | | | |

TRAIL MA 079

J001




| | | | |
|--------------------|--|--------------------------------------|--|
| PARK 00-14 | | ARIZONA DEPARTMENT OF TRANSPORTATION | |
| INTERSTATE HIGHWAY | | ROADSIDE DEVELOPMENT SECTION | |
| ROUTE 101 | | FRANK MAINTENANCE DIRECTOR | |
| SR 101 | | LOGAN TIMPEN DESIGN INC | |
| SR 101 | | 19TH AVENUE TO SCOTTSDALE ROAD | |
| SR 101 | | DRC No. 44 | |
| SR 101 | | TRACES NO. H 4845 03 C | |
| SR 101 | | RAM 600-1-563 | |
| SR 101 | | DRC No. 44 | |

MARCH LINE - STA 1815+00

MARCH LINE - STA 1802+00



0 25 50 100 150

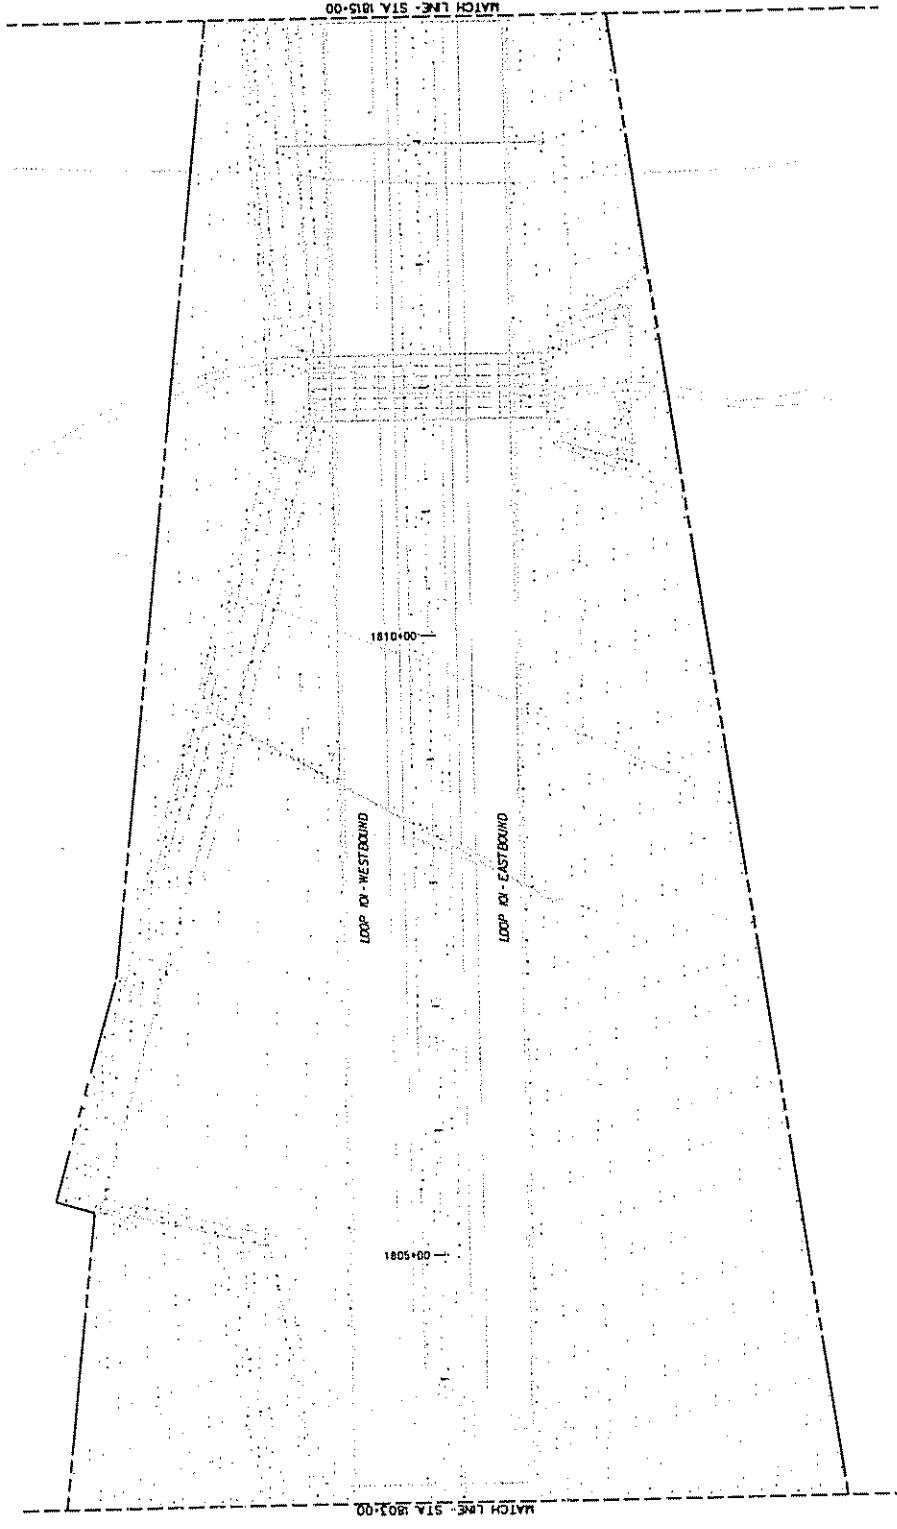



4001

CITY OF PHOENIX

| | |
|--|-------|
| JPA #001H | |
| ARIZONA DEPARTMENT OF TRANSPORTATION INTERSTATE TRANSPORTATION DIVISION ROADSIDE DEVELOPMENT SECTION | |
| EXCH | EXCH |
| SCENE | SCENE |
| PHS | PHS |
| DECED | DECED |
| LOCATE/IMPROVE DITCH INC | |
| FHWA MAINTENANCE ENTRI | |
| 2621-000 | |
| SR 101L 150 | |
| 9TH AVENUE TO SCOTTSDALE ROAD | |
| TRACES NO. H 4845 03 C RAM 600-1-563 | |
| DRC No. 44 OF 47 | |

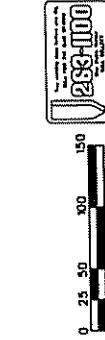

MATCH LINE STA 1828-00

MATCH LINE STA 1825-00

1823-00

1820-00

LOOP 101 WESTBOUND


LOOP 101 EASTBOUND



| | | | | |
|-----|-------|---------------|------------|---------|
| TAN | STATE | PROJECT NO. | WEST TOWNS | W. EAST |
| 9 | ARIZ. | RAA 600-1-563 | | |

DTL MA DTB

4001

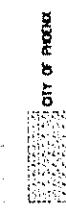

| | |
|------------|---|
| PLAT 001MA | ARIZONA DEPARTMENT OF TRANSPORTATION INTERSTATE HIGHWAY, TRANSPORTATION DIVISION ROADBED & DEVELOPMENT SECTION FINAL MAINTENANCE EXHIBIT |
| SR 101L | 19TH AVENUE TO SCOTTSDALE ROAD |
| 238-100 | TRACS NO. H 4845 03 C RAA 600-1-563 |
| 45 OF 47 | |

MAINT LINE - STA 1841-00

1840+00

1835+00

1830+00

MAINT LINE - STA 1828-00

LOOP RD - WESTBOUND

1828

LOOP RD - EASTBOUND

1829

0 25 50 100 150



ARIZONA DEPARTMENT OF TRANSPORTATION
INTERSTATE HIGHWAY, TRANSPORTATION DIVISION
ROADBED & DEVELOPMENT SECTION
FINAL MAINTENANCE EXHIBIT
DTC No. MA-45

PLAT 001MA

ARIZONA DEPARTMENT OF TRANSPORTATION
INTERSTATE HIGHWAY, TRANSPORTATION DIVISION
ROADBED & DEVELOPMENT SECTION
FINAL MAINTENANCE EXHIBIT
DTC No. MA-45

45 OF 47

| YEAR | STATE | PROJECT NO. | TYPE | STA. |
|------|-------|---------------|------|------|
| 9 | IND. | RAM 600-1-563 | RD | 020 |

NORTH

| | |
|--------------------------------------|--|
| CITY OF PHOENIX | |
| PA# 0014 | DATE 10/26/00 |
| SR 101L | SECTION 19TH AVENUE TO SCOTTSDALE ROAD |
| TRACES NO. H 4845 03 C | RAM 600-1-563 |



MAP NO. 26-47
SCALE 1:2000

MATCH LINE STA 1852-00

1850+00

1845+00

SCOTTSDALE RD. ON RAMP - WEST BOUND

LOOP RT. WEST BOUND

LOOP RT. EAST BOUND

SCOTTSDALE RD. OFF RAMP - EAST BOUND

MATCH LINE STA 1841-00


0 25 50 100 150



ADOT



ADOT

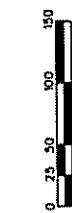


MAP NO. 26-47
SCALE 1:2000

46 OF 47

| | | | | |
|------|-------|---------------|-------------|----------|
| DATE | START | PROJECT NO. | WEEKLY STA. | AS-BUILT |
| 9 | END | RAM 600-1-563 | | |
| | | | 102 MA 020 | |

MATCH LINE - STA 1852-00

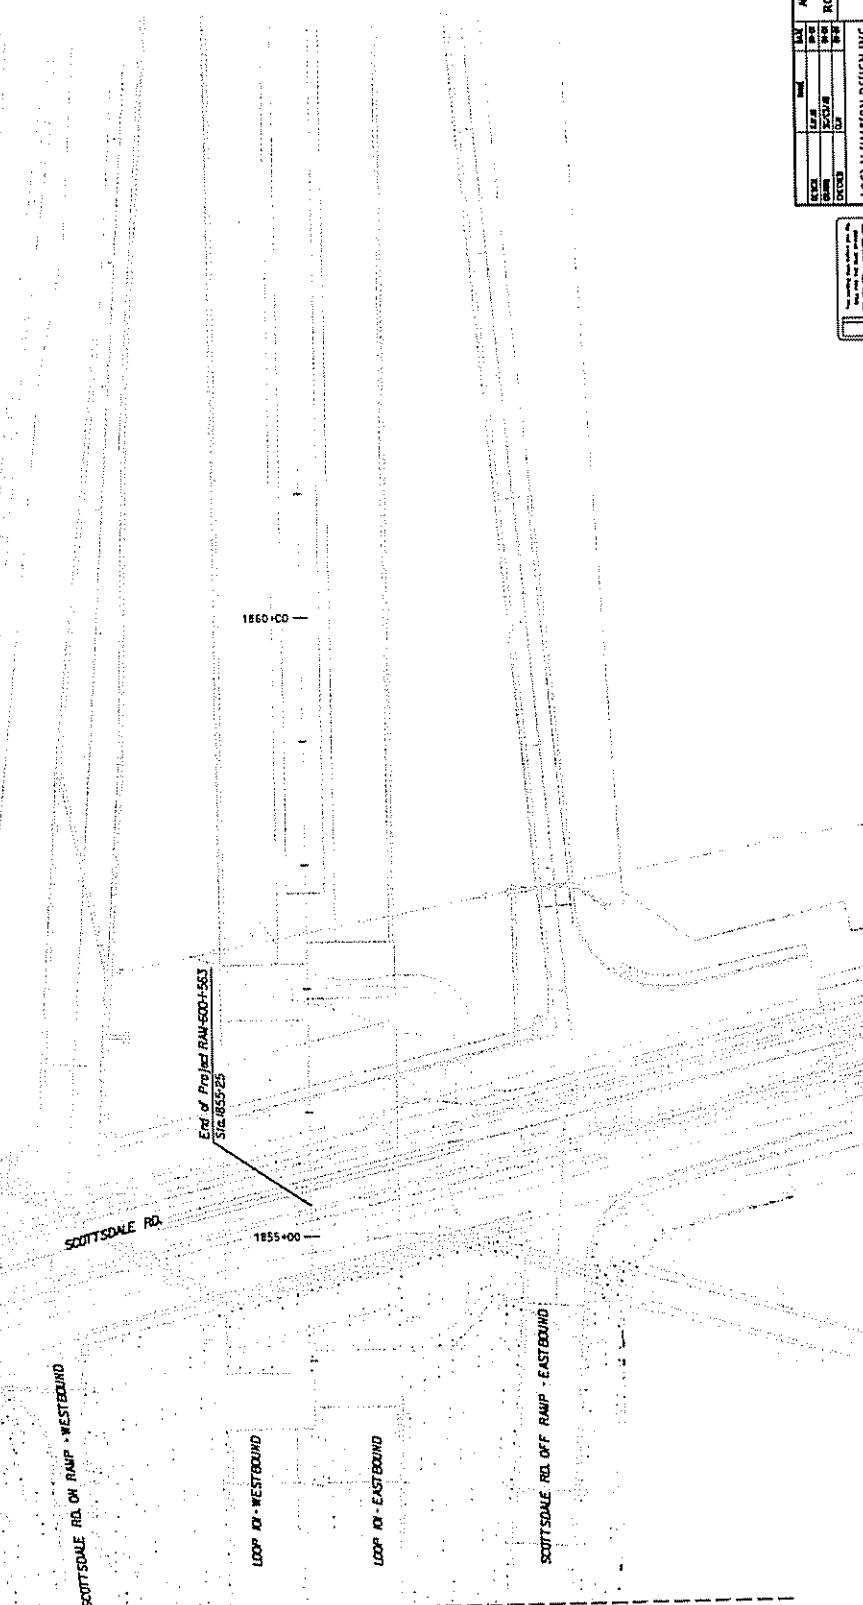

| | |
|------------------------------|--|
| SPV 00-14 | |
| PROJECT NO. H 4845 03 C | |
| TRACES NO. H 4845 03 C | |
| RAM 600-1-563 | |
| 47 OF 47 | |



CITY OF PHOENIX
REQUEST FOR COUNCIL ACTION

Complete this form per O.P. 1.906 and A.R. 4.11.

Refer to the City Council Agenda Process Reference Guide for Assistance

| | | | | |
|-------------------------|--------------------------|--|--------------------------|------------|
| ACTION REQUESTED | Formal Action: | OR | Legal Document: | |
| | Bid Award | | <input type="checkbox"/> | Ordinance |
| | License Application | | <input type="checkbox"/> | Resolution |
| | Public Hearing | | <input type="checkbox"/> | |
| Other | <input type="checkbox"/> | Emergency Clause? (for use only w/ord. or res. requests) | | |

| | | | |
|-----------------------------|--|--|--------------------------|
| IMPACTED DISTRICT(S) | DISTRICTS 1 AND 2 | ADDITIONAL BACKUP MATERIAL SENT UNDER SEPARATE COVER? | <input type="checkbox"/> |
| SUBJECT | PIMA FREEWAY; 19TH AVENUE TO SCOTTSDALE ROAD LANDSCAPE MAINTENANCE AGREEMENT | | |

| | | | |
|------------------------------|-----------|--------------------|---|
| REQUESTED AGENDA DATE | 2/21/2001 | PREPARED BY | Name: Thomas Godbee, P.E. Department: Street Transportation Phone: 495-5817 |
|------------------------------|-----------|--------------------|---|

| | | | |
|------------------|------------------|------------------------|---|
| APPROVALS | Division Head: | J. Donald Herp, P.E. | If prepared for another department: Department Name: |
| | Department Head: | Thomas E. Callow, P.E. | Approval: |

| | | |
|------------------------------|---|--|
| BID AWARD INFORMATION | Bid Surety Required? <input type="checkbox"/> Submitted by Low Bidder? <input type="checkbox"/> Contract Required? <input type="checkbox"/> | Performance Surety Required <input type="checkbox"/> Amount? _____ Requisition No. _____ |
|------------------------------|---|--|

| | | | |
|--|--|---|----------------|
| CONTRACT INFORMATION | Contract Amendment? <input type="checkbox"/> | | |
| | If Yes, Current Contract No. _____ | | |
| | Approved by: | Ordinance <input type="checkbox"/> Resolution <input type="checkbox"/> | on Date: _____ |
| Formal Action <input type="checkbox"/> | | | |

| | | |
|--------------------------------|--|--|
| BUDGET INFORMATION | \$ 301,486.00 | To Be Encumbered? <input type="checkbox"/> Fiscal Year? _____ |
| | Source of Funds: General Fund | |
| | Fund Center(s) (SAP-FM): 6300004200 | |
| | Commitment Item(s) (SAP-FM): 510330,510610 | |
| Availability of Funds Approval | Cathy Gleason | |

| | | |
|------------------------------|------------------------------------|-------------------|
| CITY MANAGER'S OFFICE | Approved by Jack Tevlin 2/12/01 | CM Control No. 36 |
|------------------------------|------------------------------------|-------------------|

| | | | |
|------------------------------|-------------------------------|------------------------|--|
| CITY CLERK DEPARTMENT | Council Action Taken: Adopted | | |
| | Ordinance Number: | RCA No. 34225 | |
| | Resolution Number: 19582 | Contract No. 96284 | |
| | Comments: | Meeting Date 2/21/2001 | |
| | | Item No. 45 | |

ITEM**DISTRICTS 1 AND 2****PIMA FREEWAY; 19TH
AVENUE TO SCOTTSDALE
ROAD LANDSCAPE
MAINTENANCE AGREEMENT**

Request to authorize the City Manager to enter into an intergovernmental agreement (IGA) with the Arizona Department of Transportation for landscape maintenance along the Pima Freeway from 19th Avenue to Scottsdale Road, per the Maintenance Agreement for this project.

With City concurrence, the State will design and construct the landscaping and irrigation system for the Pima Freeway within the Phoenix City limits.

The City will furnish and install necessary water services from water mains to the designated locations within the right-of-way at the State's expense and waive water development fees. The City will also furnish all water for landscape installation during the construction phase, and all water thereafter necessary to properly maintain the landscape, all at City expense.

After construction, the State will maintain the landscaping and irrigation system generally within the Control of Access, and the City will maintain the irrigation system generally outside the Control of Access, as designated on the Maintenance Exhibit.

The City's estimated annual water and maintenance costs per year are shown below:

| | | |
|-------------------|-------------------|---------------------|
| Water: | \$ 90,070 | (6300004200-510330) |
| Maintenance: | <u>\$ 211,416</u> | (6300004200-510610) |
| Total Annual Cost | \$ 301,486 | |

Citizen Notification

ADOT has held public meetings to receive citizen input on the design of the freeway, including the landscaping. The landscaping along the Pima Freeway will be comparable to other freeways in the City.

The freeway is scheduled to open in early summer 2001, with landscaping to be added shortly thereafter.

F:\SEC_SVCS\TEC\RCA\RCA01015.DOC



STATE OF ARIZONA

OFFICE OF THE ATTORNEY GENERAL

JANET NAPOLITANO
ATTORNEY GENERAL

1275 WEST WASHINGTON, PHOENIX, AZ 85007-2926

TRN Main: (602) 542-1680
Direct: (602) 542-8855
Fax: (602) 542-3646

MAIN PHONE : (602) 542-5025
FACSIMILE : (602) 542-4085

INTERGOVERNMENTAL AGREEMENT
DETERMINATION

A.G. Contract No. KR00-1511RN, an agreement between public agencies, has been reviewed pursuant to A.R.S. § 11-952, as amended, by the undersigned Assistant Attorney General who has determined that it is in the proper form and is within the powers and authority granted to the State of Arizona.

No opinion is expressed as to the authority of the remaining parties, other than the State or its agencies, to enter into said agreement.

DATED March 6, 2001.

JANET NAPOLITANO
Attorney General

Susan E. Davis
SUSAN E. DAVIS
Assistant Attorney General
Transportation Section

SED:ggt

Enc.

671947



JANET NAPOLITANO
ATTORNEY GENERAL

STATE OF ARIZONA
OFFICE OF THE ATTORNEY GENERAL

1275 WEST WASHINGTON, PHOENIX, AZ 85007-2926

TRN Main: (602) 542-1680
Direct: (602) 542-8855
Fax: (602) 542-3646

MAIN PHONE: (602) 542-5025
FACSIMILE: (602) 542-4085

**INTERGOVERNMENTAL AGREEMENT
DETERMINATION**

A.G. Contract No. KR00-1511RN, an agreement between public agencies, has been reviewed pursuant to A.R.S. § 11-952, as amended, by the undersigned Assistant Attorney General who has determined that it is in the proper form and is within the powers and authority granted to the State of Arizona.

No opinion is expressed as to the authority of the remaining parties, other than the State or its agencies, to enter into said agreement.

DATED March 6, 2001.

JANET NAPOLITANO
Attorney General

Susan E. Davis
SUSAN E. DAVIS
Assistant Attorney General
Transportation Section

SED:ggt

Enc.

671947